


- LEGEND**
- ⊕ Concrete Monument
 - ⊞ Electrical Transformer
 - ⊞ Gas Meter
 - ⊞ Fire Hydrant
 - Monument
 - Property Corner
 - Light Pole
 - Manhole
 - ⊞ Power Pole
 - ⊞ Cable Box
 - ⊞ Storm Inlet
 - ⊞ Telephone Pedestal
 - ▲ Traverse Point
 - ⊞ Tree
 - ⊞ Valve Box
 - ⊞ Water Meter
 - L.S.E. Landscape Easement
 - B.L. Building Line
 - U.E. Utility Easement
 - A.E. Aerial Easement
 - ### Fence

NOTES:

1. Plot Scale 1" = 30'
2. The bearings for this survey are based on the recorded plat (record deed) shown on this survey.
3. Roads dedicated by record plat (record deed) unless otherwise noted.
4. This survey was performed without benefit of a Title Report and therefore may not reflect all Building Set Back Lines, Easement, Deed Restrictions and other matters of record.

5. The professional services reflected on this plat of survey is provided in connection with the transaction anticipated by the title search referenced and dated above, it is not to be used for any other purpose. This original work is protected under copy right laws, 17 United States Code Section 101 and 102. All violators will be prosecuted to the fullest extent of the law. This survey is being provided solely for the use of the recipients named below and no license has been created, expressed or implied, to copy the survey except as is necessary, in conjunction with the original transaction, which shall take place within thirty (30) days from the date shown hereon.
6. 5/8" Iron Rods with survey cap marked "Glezman 4627" set at all property corners unless otherwise noted.

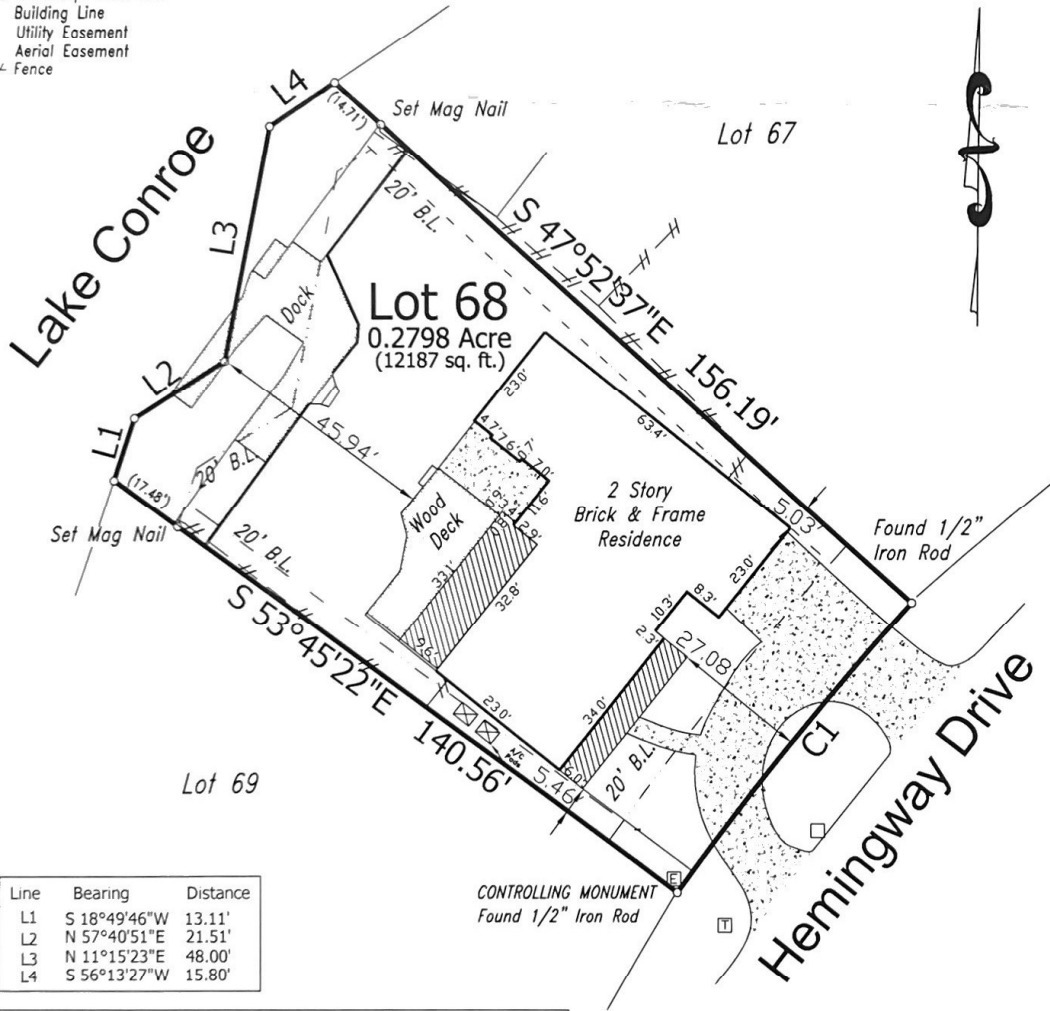

Line	Bearing	Distance
L1	S 18°49'46"W	13.11'
L2	N 57°40'51"E	21.51'
L3	N 11°15'23"E	48.00'
L4	S 56°13'27"W	15.80'

Curve	Delta Angle	Radius	Arc Tangent	Chord Bearing	Chord
C1	05°53'18"	730.00'	75.02'	N39°11'59" E	74.99'

Line Used for Directional Control

Lot 68, Block 19, Walden On Lake Conroe, Section 4, a Subdivision in Montgomery County, Texas, according to the map or plat thereof recorded in Cabinet A, Sheet 63 of the Map Records of Montgomery County, Texas.

If this plat and accompanying description are not sealed with the raised seal of RPLS whose signature appears on the raised seal and in red ink, it is considered a copy, and not a legal original. See Note 5 above.

Purchaser: Lonnie Smith
 Address: 3127 Hemmingway Drive
 Montgomery, TX 77356

Revised: 1/19/16
 Date: 1/06/16
 Job No: 2016-001 (C.M.)

RPLS # 4627



T0: Lonnie Smith

We, Glezman Surveying, Inc., acting by and through Michael Glezman, a Registered Professional Land Surveyor in the State of Texas, certify that this survey and professional services substantially complies with the Texas Society of Professional Surveyors Standards and Specifications for a Category 1B, Condition III Survey.

©2015 All Rights Reserved

Surveying Southeast Texas since 1987
GLEZMAN SURVEYING, INC.
 1938 Old River Road, Montgomery, Texas 77536
 Firm No. 10039200
 Office (936) 582-6340 www.glezmansurveying.com

