


RESTRICTED RESERVE "A"

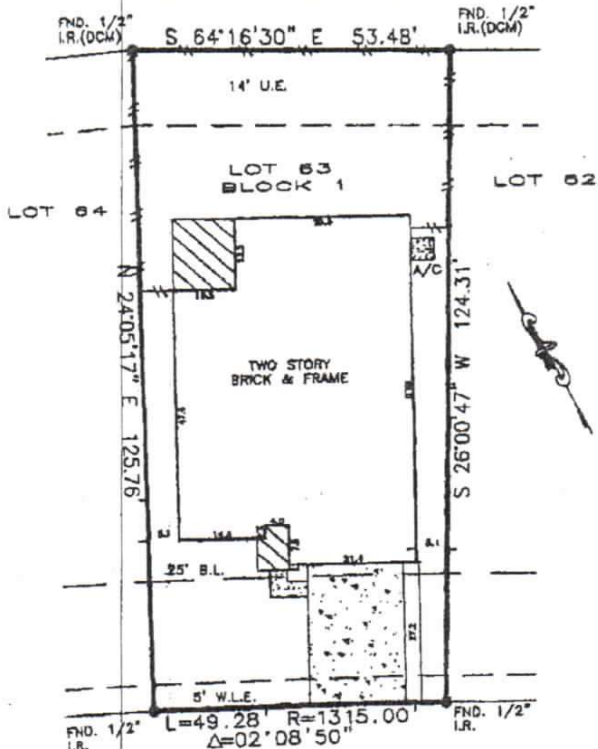

MAY APPLE COURT

H.L. & P. Company agreement (0926114)
 Unstructured drainage easement (V103559)
 DCM=Directional Control Movement
 Bearings based on subdivision plat.
 Easements and Building Lines (B.L.)

as provided by Title Company.

FLOOD PLAN INFORMATION

ZONE: "X"
 PANEL: 48201C-0195
 DATE: 8-18-07
 O.F. NO.: 09-15841
 JOB NO.: 08074908
 SCALE: 1" = 20'

Purchaser: MAX D. BUKKES
 Address: 21738 MAY APPLE COURT CYPRESS, TEXAS 77433
 Lot: 63 Block: 1 Sec: 3
 Survey: _____
 Area: _____
 Subd: FARFIELD VILLAGE SOUTH
 F.C. No.: 552147, M.R. HARRIS COUNTY, TEXAS

To LSI TITLE AGENCY, INC.

The undersigned does hereby certify that this survey was this day made, on the ground of the property, legally described hereon and correct, and that there are no encroachments, conflicts, shortages in area, boundary line conflicts, vested encroachments, overlapping or inconsistent easements or apparent rights-of-way, except as shown hereon, and said property has access to and from dedicated roadway, except as shown hereon.

This document is copyright protected with a production date as delineated below.
 This survey is valid only with impression seal signed in red ink.

Dated this 30th day of JUNE 2008 ROBERT A. LAPLANT JR.
 RPLS 5234

LaPLANT SURVEYORS, INC.
 1503 840 NORTH DRIVE HOUSTON, TEXAS 77080
 (281) 440-8880 FAX 281-440-8510

