

- GRAVE MARK
- WIRE FENCE
- WOOD FENCE
- POWER POLE
- CONCRETE
- CONTROL MONUMENT
- FOUND CORNER
- FIRE HYDRANT
- CHAIN LINK FENCE
- WATER VALVE
- CLEAN OUT
- POWER LINE
- WATER METER
- ELECTRIC BOX
- COVERED
- CALL

- CLF = CHAIN LINK FENCE
- UE = UTILITY EASEMENT
- AE = AERIAL EASEMENT
- WLE = WATERLINE EASEMENT
- SSM NH = STORM SEWER MANHOLE
- SSM NH = SANITARY SEWER MANHOLE
- BL = BUILDING LINE
- PL = BOUNDARY LINE
- PP = POWER POLE
- MM = MANHOLE
- FND = FOUND
- IR = IRON ROD
- IRP = IRON PIPE
- FNC = FENCE
- GBL = GARAGE BUILDING LINE (DETACHED)
- P.T.P. = PINCHED TOP PIPE

COMMON ABBREVIATIONS


NO.	DATE	REASON	BY	NO.	DATE	REASON	BY
1	03-14-14	TREES	M. COX	5	05-11-15	FINAL	TOA
2	04-15-14	AERIAL EASEMENT	M. COX	6	05-19-15	CHECK FENCE	TOA
3	05-06-14	DITCH	M. COX				
4	11-23-14	FORM	DMN				

REVISIONS

NO.	DATE	REASON	BY
1	03-14-14	TREES	M. COX
2	04-15-14	AERIAL EASEMENT	M. COX
3	05-06-14	DITCH	M. COX
4	11-23-14	FORM	DMN


I HEREBY DECLARE THAT THE ELEVATIONS AND DRAINAGE PATTERNS SHOWN HEREON WERE DEVELOPED FROM A SURVEY OF THIS PROPERTY ACQUAINTLY RELATIVE ELEVATIONS AS THEY EXISTED. THE RELATIVE ELEVATIONS AS DEPICTED MAY CHANGE SUBSEQUENT TO THE DATE OF THIS SURVEY DUE TO ADDITION OR REMOVAL OF THE SOIL BY ACTS OF MAN, EROSION BY WIND OR WATER OR OTHER FACTORS. THE HOMEOWNER MUST MAINTAIN THESE ELEVATIONS AND GRADES TO PROPERLY DRAIN THE WATER AWAY FROM THE HOME.

REMLAP STREET (60' R.O.W.)

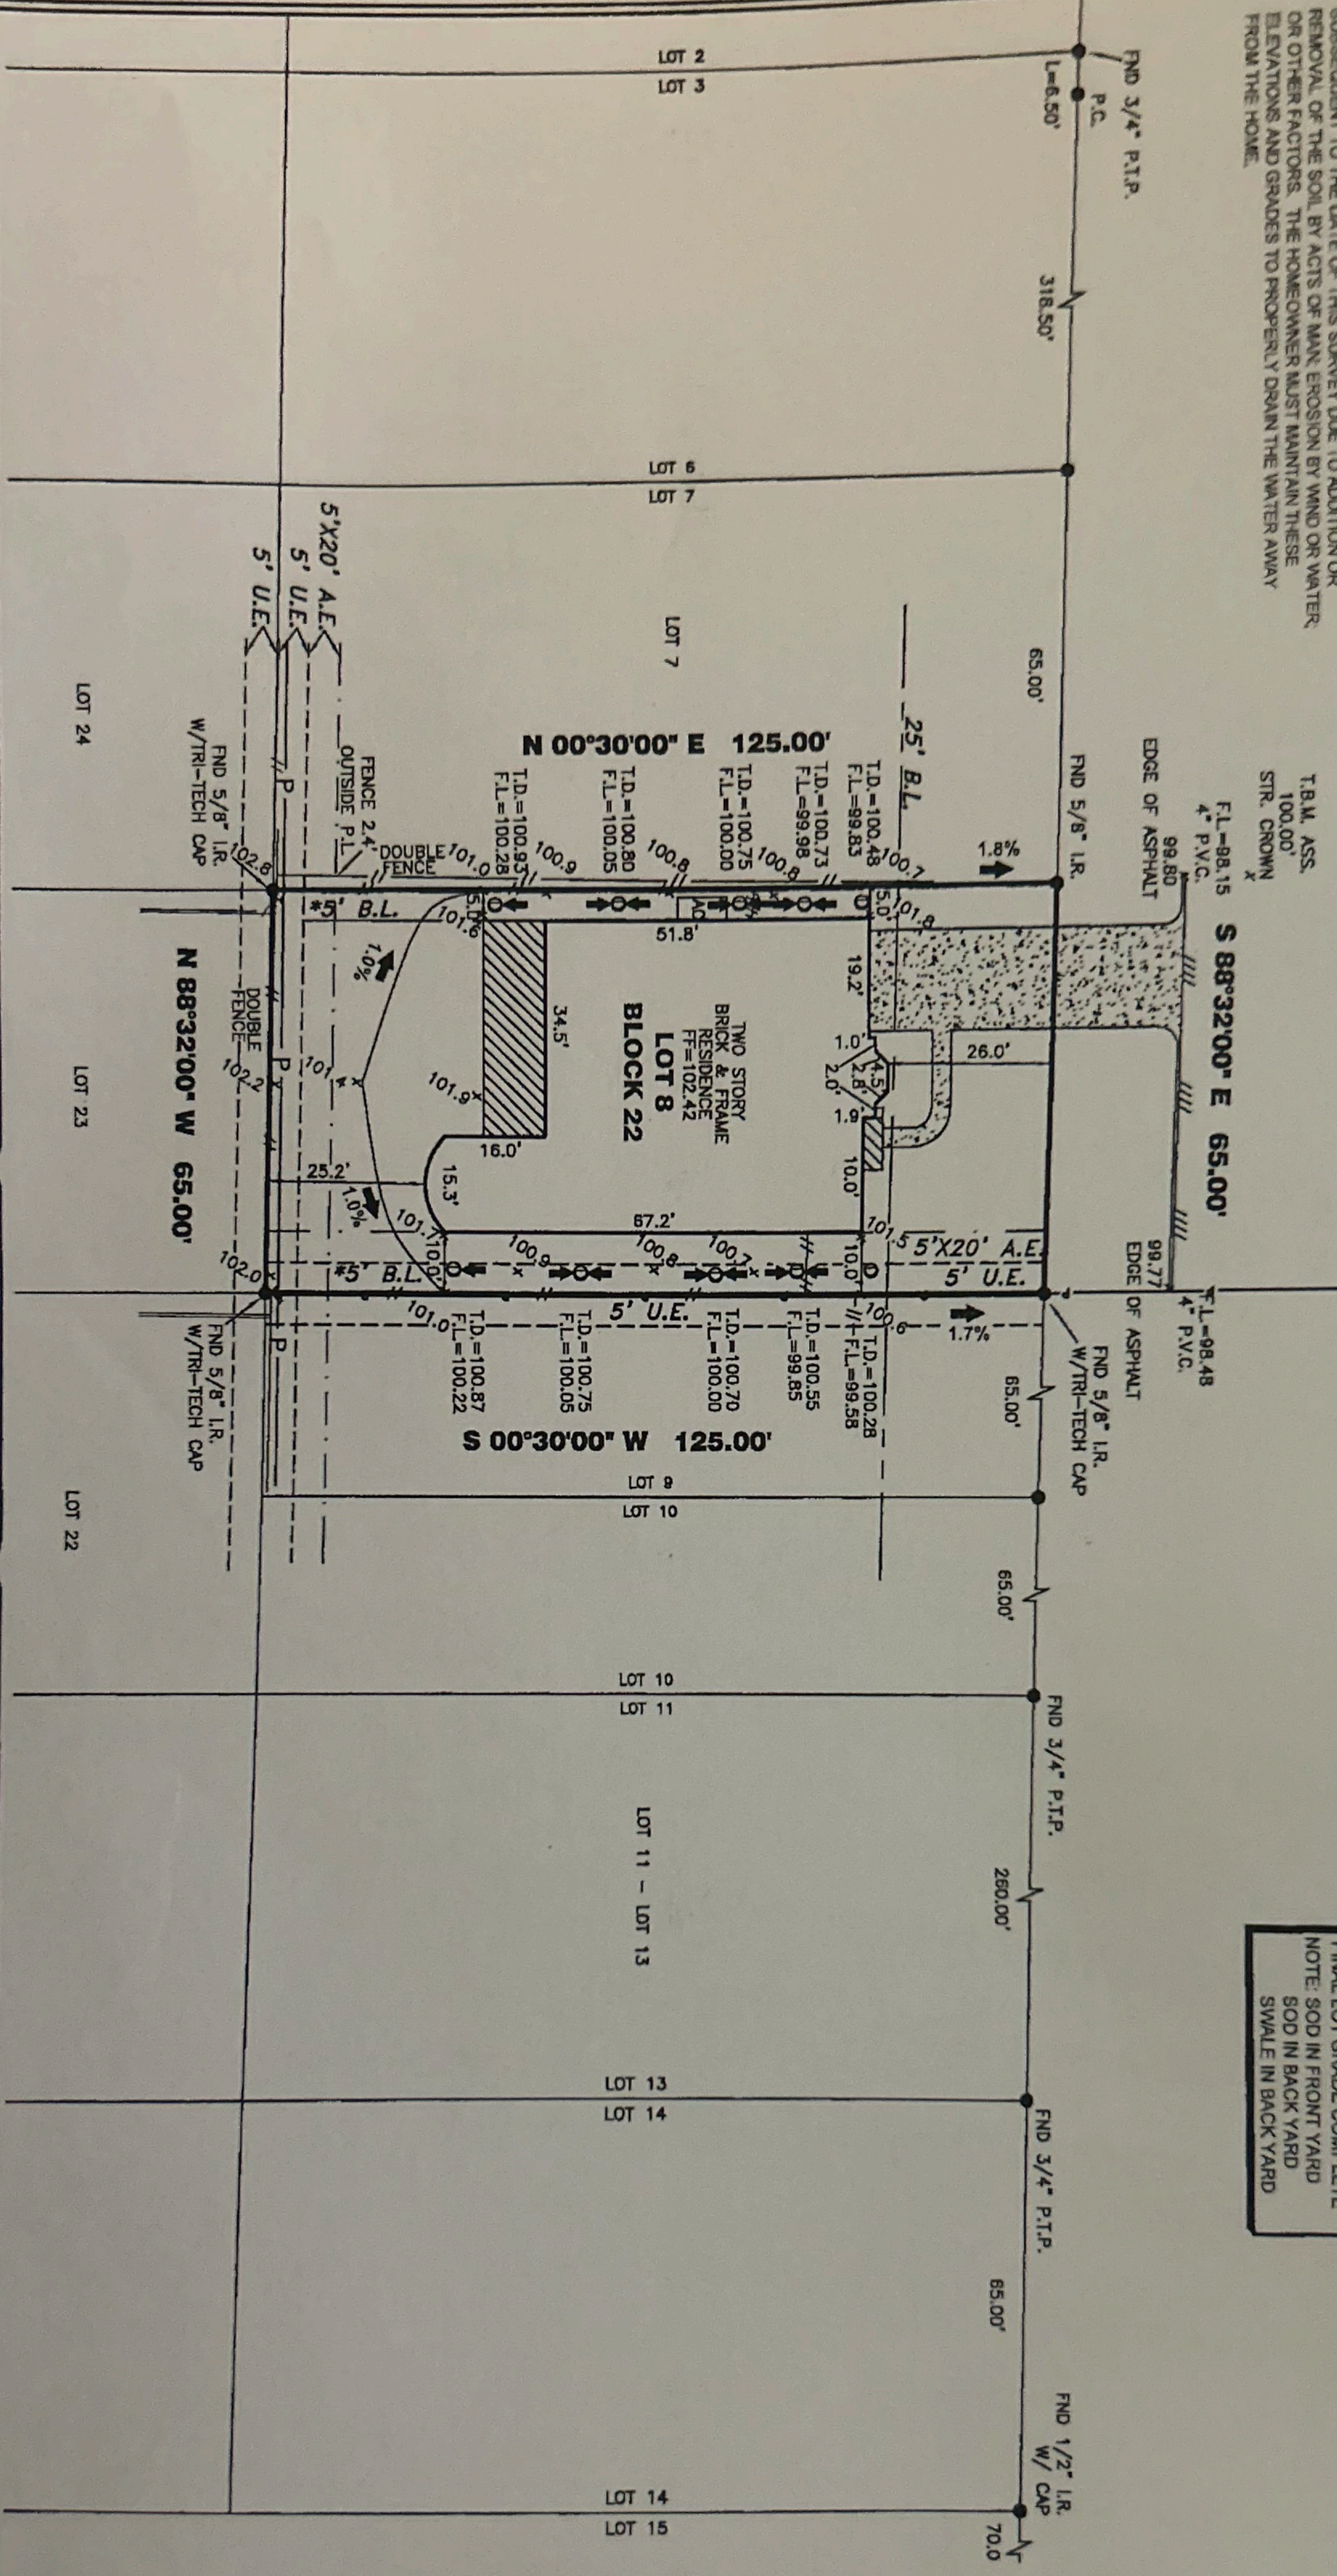

FINAL LOT GRADE COMPLETE
NOTE: SOD IN FRONT YARD
SOD IN BACK YARD
SWALE IN BACK YARD

NOTES:
ALL DIMENSIONS AND RELATIONS SHOWN ARE FOR THE RECORD ONLY. FIELD MEASUREMENTS SHALL BE USED TO VERIFY THE ACCURACY OF THE RECORD DRAWING. THE SURVEYOR'S OFFICE SHALL BE RESPONSIBLE FOR THE ACCURACY OF THE RECORD DRAWING. THE SURVEYOR'S OFFICE SHALL BE RESPONSIBLE FOR THE ACCURACY OF THE RECORD DRAWING.

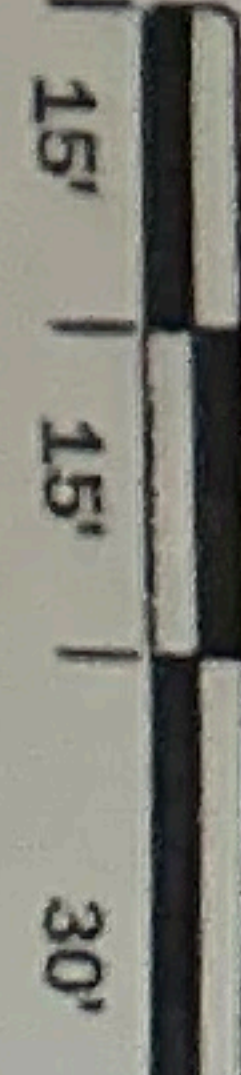

TRI-TECH SURVEYING COMPANY, L.P.
W/W/SURVEYINGCOMPANY.COM
10401 Westridge Drive Houston, Texas 77042
Phone: (713) 667-0800 Fax: (713) 667-4610
P.L.M. Registration No. 10115900

FLOOD INFORMATION
F.L.M. NO.: 48201C PANEL: 0665L
REVISED DATE: 06-18-2007 ZONE: "X"
FLOOD INFORMATION PROVIDED HEREON IS BASED ON SCALING THE LOCATION OF THE SUBJECT TRACT ON THE FLOOD INSURANCE RATE MAPS. THE INFORMATION SHOULD BE USED TO DETERMINE FLOOD INSURANCE RATES ONLY AND IS NOT INTENDED TO IDENTIFY SPECIFIC FLOODING CONDITIONS. WE ARE NOT RESPONSIBLE FOR THE F.L.M.'S ACCURACY. FLOOD INFORMATION IS SUBJECT TO LETTER OF MAP CHANGES.

PROPERTY ADDRESS
6429 REM LAP STREET
HOUSTON, HARRIS COUNTY, TEXAS 77055

PROPERTY INFORMATION
LOT: 8 Block: 22
SUBDIVISION: WESTVIEW TERRACE, SECT 2
RECORDING INFO: VOLUME 30, PAGE 34
BORROWER: DAVID RICHARD HOFMAN AND JENNIFER WONEIDURF HOFMAN
TITLE CO: CHICAGO TITLE / EXECUTIVE TITLE CO., LTD.
G.F.#: ETH1500395 G.F. DATE: 04-14-15
SURVEYED FOR: PERRY HOMES, LLC

DRAWING INFORMATION
JOB NO: MY222-13
CALC BY: M. COX
DRAWN BY: GABE H.
CHECKED BY: C. CONDRON
FIELD CREW: M. MORAN
FIELD DATE: 12-03-13
BEARING BASE: REFERRED TO PLAT NORTH

CERTIFICATION P.L.M. REG. NUMBER 10115900
I, the undersigned registered professional land surveyor, do hereby state that the plat shown hereon represents a boundary survey made on the ground under my supervision of this tract or parcel of land, according to the map or plat thereof, indicated hereon.

