
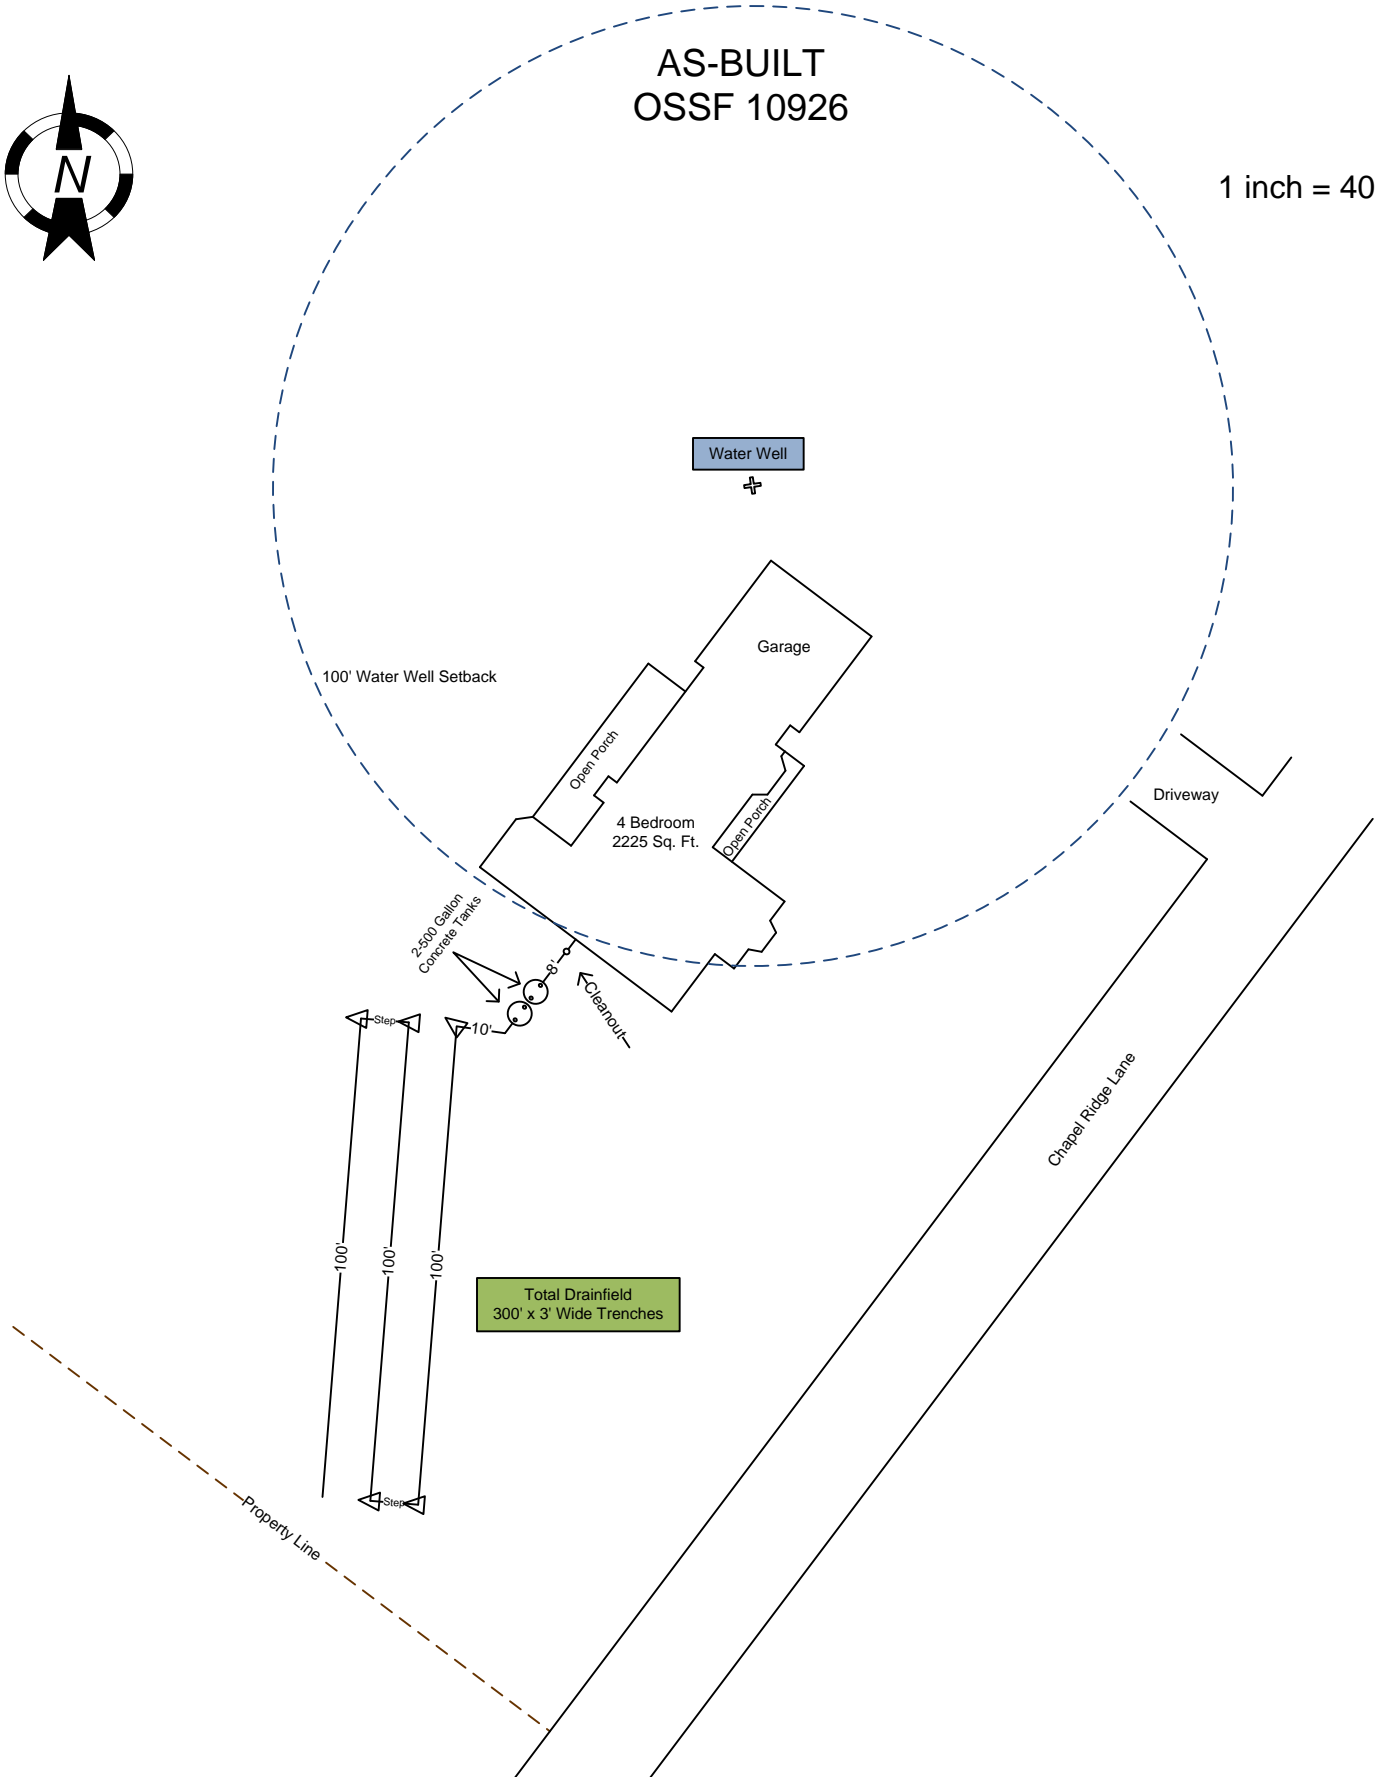


WASHINGTON COUNTY
ENVIRONMENTAL DEPARTMENT

AS-BUILT
OSSF 10926

1 inch = 40 feet

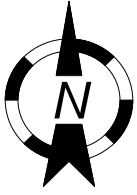

RENEE KMIEC
Designated Representative

OS25772

12/5/11
DATE