


30 scale

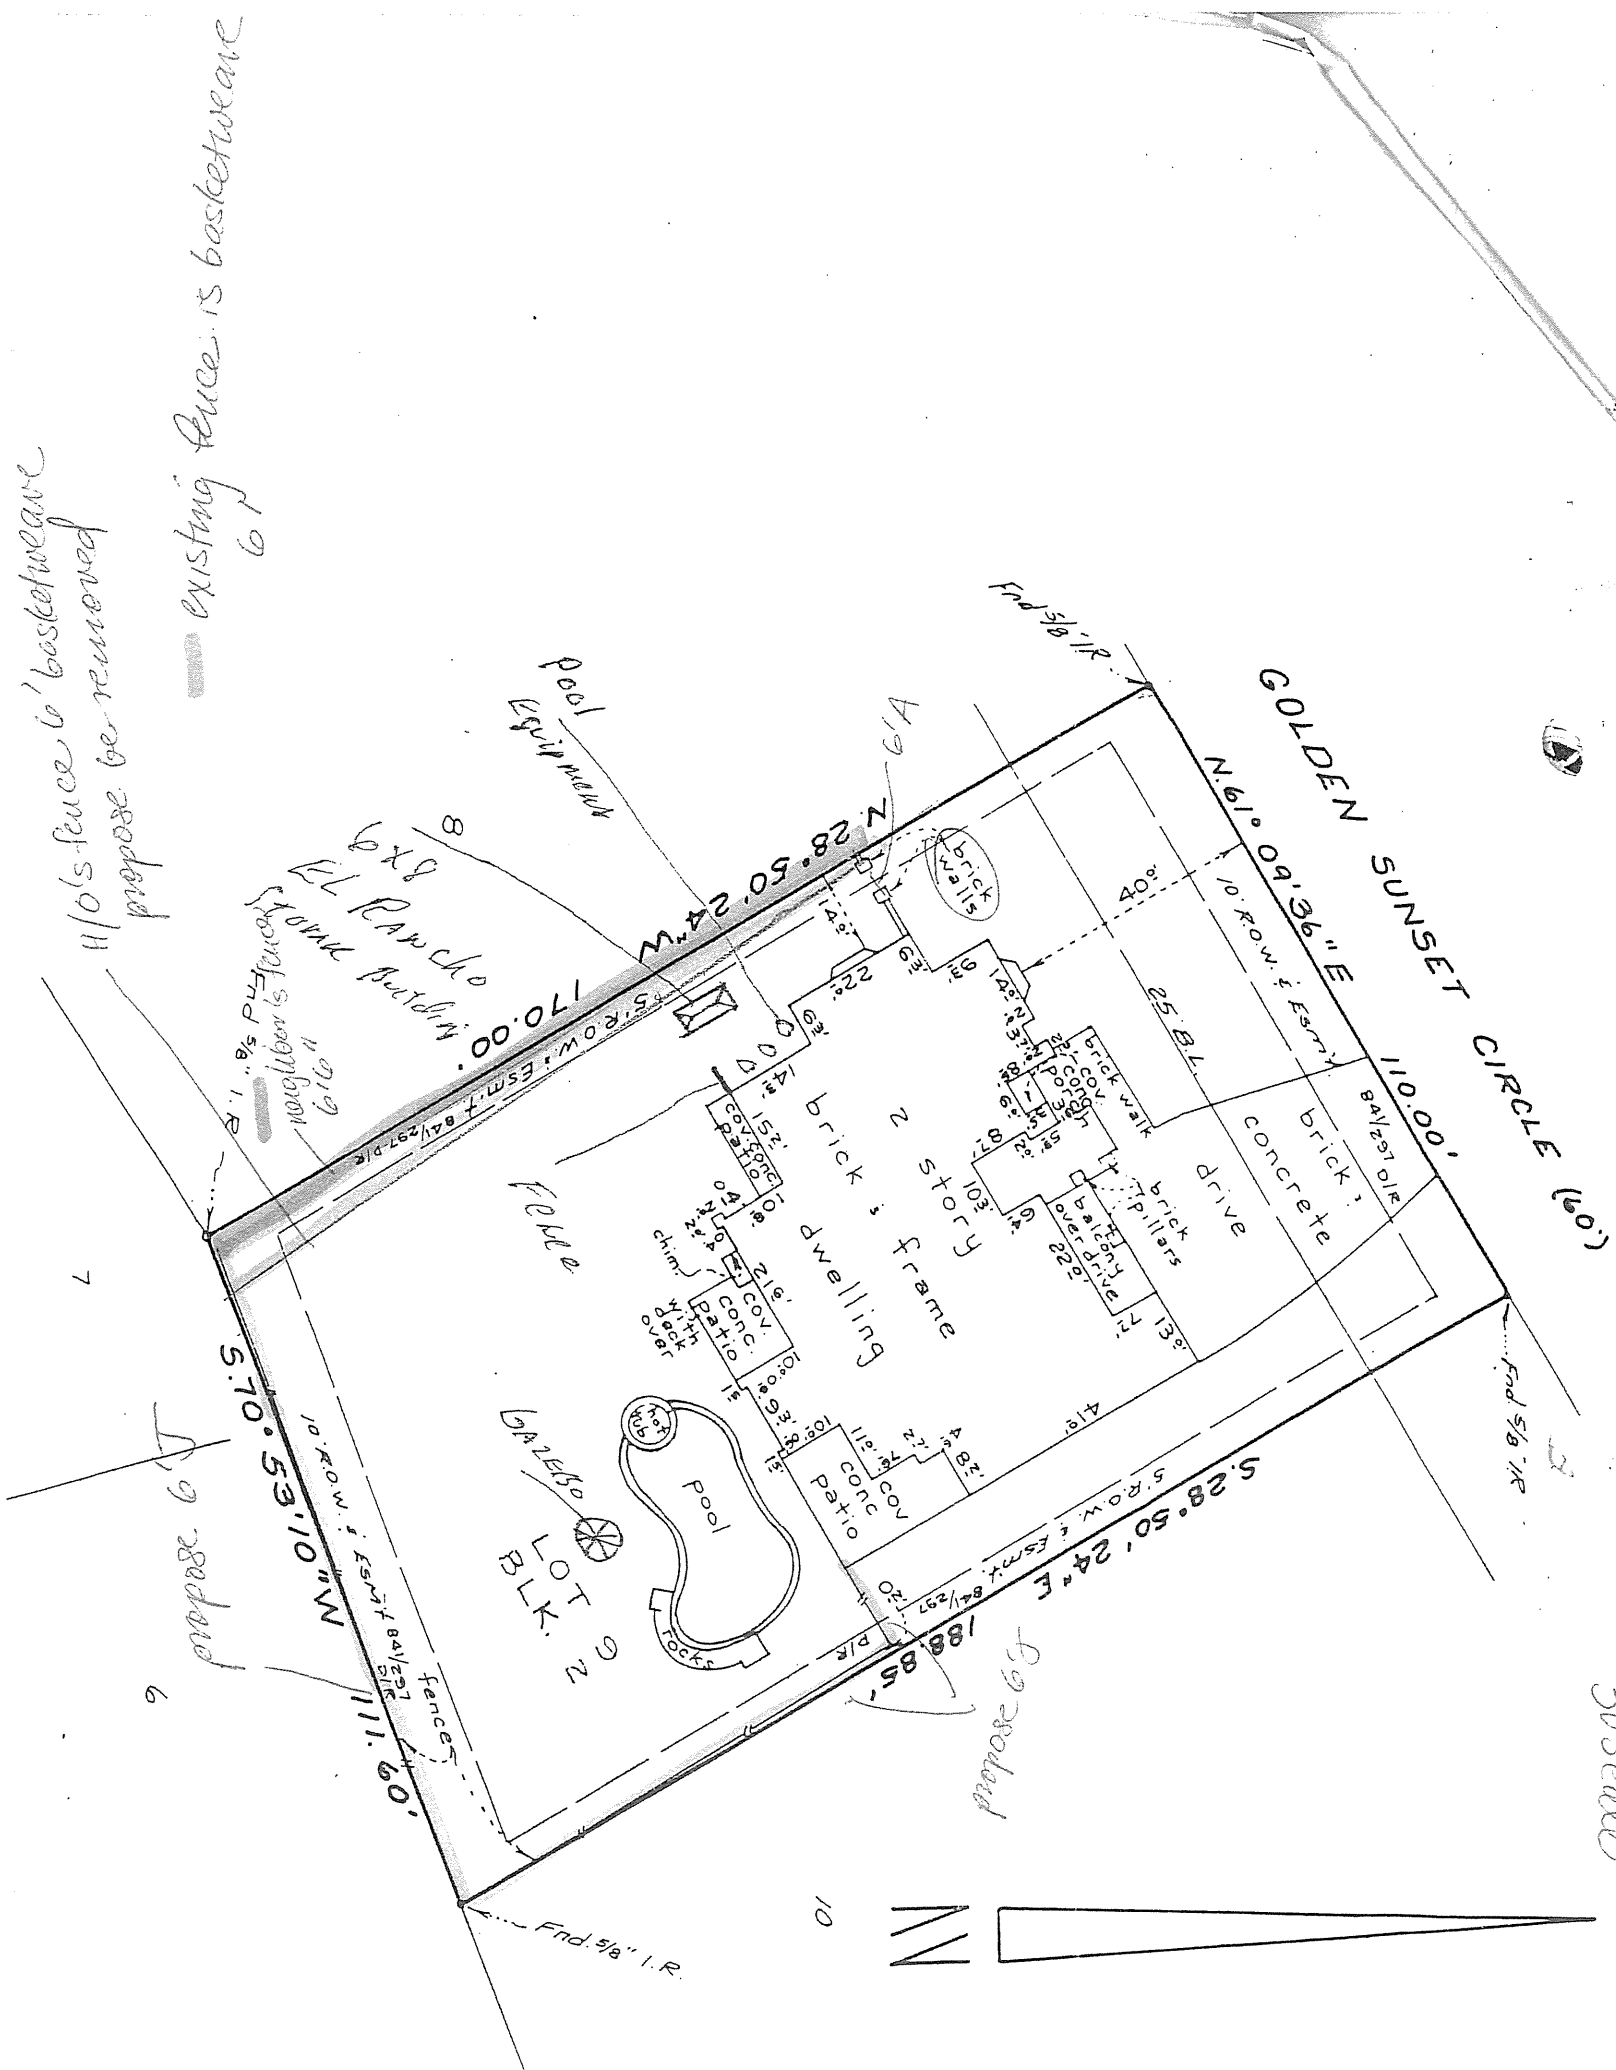

LAND TITLE SURVEY

LOT 9, BLOCK 2

THE WOODLANDS, VILLAGE OF COCHRANS CROSSING, SECTION 4
A SUBDIVISION IN THE HENRY DUNMAN SURVEY A-163


MONTGOMERY COUNTY, TEXAS. REF. Cabinet D, Sheet 154A Map Records
Scale: 1" = 30' Date: March 30, 1989

Address: 18 Golden Sunset Circle, The Woodlands, TX 77381
This property does not lie within the 100 year Flood plain per F.E.M.A.
Community-Panel #480483-0205 D revised January 6, 1988.

To Phillip W. Bork, III and wife Karen Thacker Bork Exclusively.

I hereby certify that this survey was made on the ground, and that this plat correctly represents the facts found at the time of the survey and that this professional service conforms to the current Texas Surveyors Association Standards and Specifications for a Category 1-A Condition III Survey. I further certify that there are no encroachments on this property at this time and that all improvements, if any, lie within the boundary lines except as shown.

Robert E. Maddux, Jr.
R.P.S. No. 4513

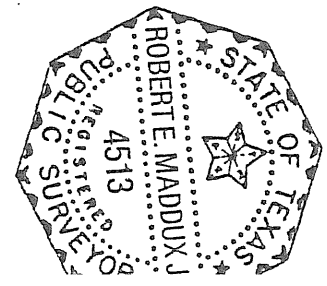

GF# 88010119 File # 89-TM-236
Book Pg

Permit # 15909 Page 5 of 5

Approved as submitted

VILLAGE OF COCHRANS CROSSING
APPROVED FOR DESIGN ONLY
3/22/90 Date nick

Conditionally approved
(see comments below)

NOTE: Construction must be completed within 90 days