

**LEGEND** \* ITEMS THAT MAY APPEAR IN \* DRAWING BELOW

A.E. = AERIAL EASEMENT  
 B.L. = BUILDING LINE  
 BRS = BEARS  
 C.F.# = CLERK'S FILE NUMBER  
 D.E. = DRAINAGE EASEMENT  
 E.E. = ELECTRIC EASEMENT  
 F.I.P. = FOUND IRON PIPE  
 F.I.R. = FOUND IRON ROD  
 FND. = FOUND

M.P. = METAL POST  
 M.U.E. = MUNICIPAL UTILITY EASEMENT  
 P.A.E. = PERMANENT ACCESS EASEMENT  
 P.C. = POINT OF CURVATURE  
 P.C.C. = POINT OF COMPOUND CURVATURE  
 P.E. = POOL EQUIPMENT  
 P.O.C. = POINT OF COMMENCING  
 P.O.B. = POINT OF BEGINNING  
 P.P. = POWER POLE

P.R.C. = POINT OF REVERSE CURVATURE  
 P.T. = POINT OF TANGENCY  
 P.U.E. = PUBLIC UTILITY EASEMENT  
 S.I.R. = SET IRON ROD  
 S.S.E. = SANITARY SEWER EASEMENT  
 S.T.M.S.E. = STORM SEWER EASEMENT  
 U.T.S. = UNABLE TO SET  
 U.E. = UTILITY EASEMENT  
 W.L.E. = WATER LINE EASEMENT  
 W.P. = WOODEN POST  
 W.S.E. = WATER & SEWER EASEMENT  
 S.F.N.F. = SEARCHED FOR, NOT FOUND

- - - - - NOT TO SCALE  
 (A) = GUY ANCHOR  
 (P) = POWER POLE  
 (S) = SERVICE DROP


(C) = CONTROL MONUMENT  
 (●) = PROPERTY CORNER  
 (○) = PROPERTY LINE  
 (---) = EASEMENT LINE  
 (---) = BUILDING SETBACK LINE  
 (---) = BUILDING WALL

(---) = WOODEN FENCE  
 (---) = CHAIN LINK FENCE  
 (---) = METAL FENCE  
 (---) = WIRE FENCE  
 (---) = VINYL FENCE  
 (---) = OVERHEAD ELECTRIC POWER LINE

LINE	BEARING	DISTANCE
L1	S 44°37'54" W	14.14'



10703 BUFFALO BEND DRIVE  
 (50' R.O.W.)

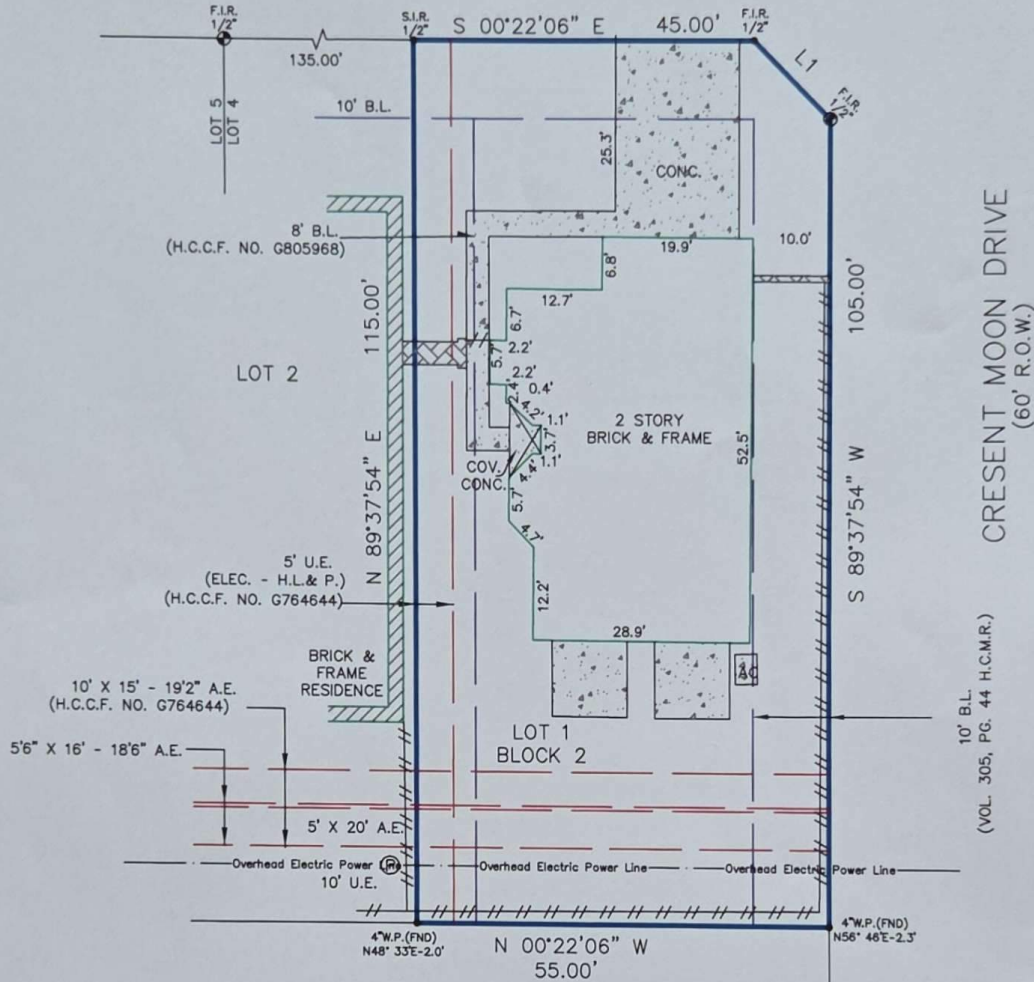

UNRESTRICTED RESERVE "A"  
 CHELSEA PARK APARTMENTS  
 (VOL. 319, PG. 85 H.C.M.R.)

Reviewed & Accepted by: \_\_\_\_\_ Date \_\_\_\_\_ / \_\_\_\_\_ / \_\_\_\_\_ Date \_\_\_\_\_

**NOTES:**  
 - BEARING BASIS: PLAT  
 - SUBJECT TO ANY AND ALL RECORDED AND UNRECORDED EASEMENTS  
 - SURVEYOR HAS NOT INDEPENDENTLY ABSTRACTED PROPERTY  
 - UNDERGROUND UTILITY INSTALLATIONS, UNDERGROUND IMPROVEMENTS, FOUNDATIONS AND/OR OTHER UNDERGROUND STRUCTURES WERE NOT LOCATED BY THIS SURVEY  
 - THIS SURVEY IS CERTIFIED FOR THIS TRANSACTION ONLY. IT IS NOT TRANSFERABLE TO ADDITIONAL INSTITUTIONS OR SUBSEQUENT OWNERS  
 - SUBJECT TO RESTRICTIVE COVENANTS AS PER TITLE COMMITMENT  
 - SUBJECT TO ZONING AND BUILDING ORDINANCES ENFORCED BY LOCAL MUNICIPALITIES  
 - ZERO LINE SETBACK: ONE WALL OF THE BUILDING, CARPORT OR GARAGE SHALL BE LOCATED ON ONE SIDE LOT LINE ON INTERIOR LOTS. HOWEVER, THIS WALL SHALL NOT HAVE ANY WINDOWS, DOORS OR OTHER SUCH RELATED OPENINGS. THE OTHER WALL OF THE BUILDING, CARPORT OR GARAGE SHALL BE A MINIMUM OF 8 FEET TO AN INTERIOR LOT LINE OR 10 FEET TO AN EXTERIOR LOT LINE ON A CORNER LOT AS SET FORTH IN INSTRUMENT RECORDED UNDER HARRIS COUNTY CLERK'S FILE NO. G805968  
 - AGREEMENT FOR UNDERGROUND ELECTRIC SERVICE WITH H.L.&P., C.F. #G829392  
 - FENCES DO NOT FOLLOW PROPERTY LINES. NO ACCESS TO ADJOINING PROPERTIES TO CHECK FOR POSSIBLE ENCROACHMENTS

**LEGAL DESCRIPTION**  
 LOT ONE (1), IN BLOCK TWO (2), OF WHITE OAK BEND, SECTION TWO (2), A SUBDIVISION IN HARRIS COUNTY, TEXAS, ACCORDING TO THE MAP OR PLAT THEREOF, RECORDED IN VOLUME 295, PAGE 99 OF THE MAP RECORDS OF HARRIS COUNTY, TEXAS.

THALIA PUENTE

ADDRESS

10703 BUFFALO BEND DRIVE



I DO HEREBY CERTIFY THAT THIS SURVEY WAS THIS DAY MADE ON THE GROUND OF THE PROPERTY LEGALLY DESCRIBED HEREON (OR ON ATTACHED SHEET), AND THERE ARE NO ENCROACHMENTS EXCEPT AS SHOWN, AND WAS DONE BY ME OR UNDER MY SUPERVISION, AND CONFORMS TO OR EXCEEDS THE CURRENT STANDARDS AS ADOPTED BY THE TEXAS BOARD OF PROFESSIONAL ENGINEERS AND LAND SURVEYORS.

JOB # 2112197

DATE 12-13-2021

GF# 21013330

**PRO-SURV**

P.O. BOX 1366, FRIENDSWOOD, TX 77549  
 PHONE: 281-996-1113 FAX: 281-996-0012  
 EMAIL: orders@prosurv.net  
 T.B.P.E.L.S. FIRM #10119300

ONLY SURVEY MAPS WITH THE SURVEYOR'S ORIGINAL SIGNATURE ARE GENUINE TRUE AND CORRECT COPIES OF THE SURVEYOR'S ORIGINAL WORK AND OPINION

© 2021 PRO-SURV - ALL RIGHTS RESERVED

**LEGEND** \* ITEMS THAT MAY APPEAR IN \*  
DRAWING BELOW

A.E. = ADRIAL EASEMENT  
 B.L. = BUILDING LINE  
 BRS = BEARS  
 C.F.# = CLERK'S FILE NUMBER  
 D.E. = DRAINAGE EASEMENT  
 E.E. = ELECTRIC EASEMENT  
 F.I.P. = FOUND IRON PIPE  
 F.I.R. = FOUND IRON ROD  
 FND. = FOUND

M.P. = METAL POST  
 M.U.E. = MUNICIPAL UTILITY EASEMENT  
 P.A.E. = PERMANENT ACCESS EASEMENT  
 P.C. = POINT OF CURVATURE  
 P.C.C. = POINT OF COMPOUND CURVATURE  
 P.E. = POOL EQUIPMENT  
 P.O.C. = POINT OF COMMENCING  
 P.O.B. = POINT OF BEGINNING  
 P.P. = POWER POLE


P.R.C. = POINT OF REVERSE CURVATURE  
 P.T. = POINT OF TANGENCY  
 P.U.E. = PUBLIC UTILITY EASEMENT  
 S.I.R. = SET IRON ROD  
 S.S.E. = SANITARY SEWER EASEMENT  
 S.M.S.E. = STORM SEWER EASEMENT  
 U.T.S. = UNABLE TO SET  
 U.E. = UTILITY EASEMENT  
 W.L.E. = WATER LINE EASEMENT  
 W.P. = WOODEN POST  
 W.S.E. = WATER & SEWER EASEMENT  
 S.F.N.F. = SEARCHED FOR, NOT FOUND

--- NOT TO SCALE  
 (A) = GUY ANCHOR  
 (P) = POWER POLE  
 (S) = SERVICE DROP


(C) = CONTROL MONUMENT  
 (●) = PROPERTY CORNER  
 --- PROPERTY LINE  
 --- EASEMENT LINE  
 --- BUILDING SETBACK LINE  
 --- BUILDING WALL

--- WOODEN FENCE  
 --- CHAIN LINK FENCE  
 --- METAL FENCE  
 --- WIRE FENCE  
 --- VINYL FENCE  
 --- OVERHEAD ELECTRIC POWER LINE

LINE TABLE		
LINE	BEARING	DISTANCE
L1	S 44°37'54" W	14.14'

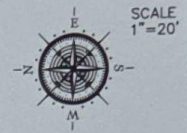

10703 BUFFALO BEND DRIVE  
 (50' R.O.W.)

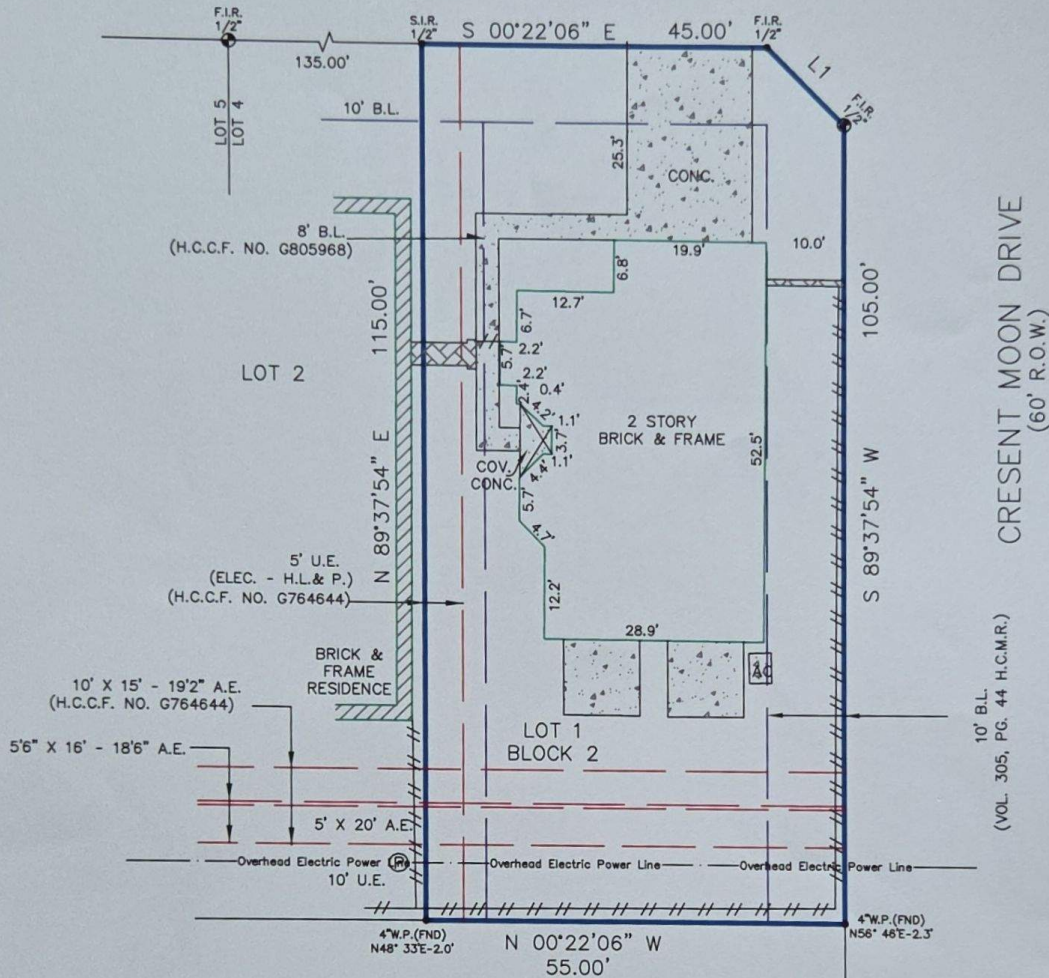

UNRESTRICTED RESERVE "A"  
 CHELSEA PARK APARTMENTS  
 (VOL. 319, PG. 85 H.C.M.R.)

Reviewed & Accepted by: \_\_\_\_\_ Date \_\_\_\_\_

Date \_\_\_\_\_

Date \_\_\_\_\_

**NOTES:**

- BEARING BASIS: PLAT
- SUBJECT TO ANY AND ALL RECORDED AND UNRECORDED EASEMENTS
- SURVEYOR HAS NOT INDEPENDENTLY ABSTRACTED PROPERTY
- UNDERGROUND UTILITY INSTALLATIONS, UNDERGROUND IMPROVEMENTS, FOUNDATIONS AND/OR OTHER UNDERGROUND STRUCTURES WERE NOT LOCATED BY THIS SURVEY
- THIS SURVEY IS CERTIFIED FOR THIS TRANSACTION ONLY, IT IS NOT TRANSFERABLE TO ADDITIONAL INSTITUTIONS OR SUBSEQUENT OWNERS
- SUBJECT TO RESTRICTIVE COVENANTS AS PER TITLE COMMITMENT
- SUBJECT TO ZONING AND BUILDING ORDINANCES ENFORCED BY LOCAL MUNICIPALITIES
- ZERO LINE SETBACK, ONE WALL OF THE BUILDING, CARPORT OR GARAGE SHALL BE LOCATED ON ONE SIDE LOT LINE ON INTERIOR LOTS. HOWEVER, THIS WALL SHALL NOT HAVE ANY WINDOWS, DOORS OR OTHER SUCH RELATED OPENINGS. THE OTHER WALL OF THE BUILDING, CARPORT OR GARAGE SHALL BE A MINIMUM OF 8 FEET TO AN INTERIOR LOT LINE OR 10 FEET TO AN EXTERIOR LOT LINE ON A CORNER LOT AS SET FORTH IN INSTRUMENT RECORDED UNDER HARRIS COUNTY CLERK'S FILE NO. G805968
- AGREEMENT FOR UNDERGROUND ELECTRIC SERVICE WITH H.L.#, C.F. #0829392
- FENCES DO NOT FOLLOW PROPERTY LINES. NO ACCESS TO ADJOINING PROPERTIES TO CHECK FOR POSSIBLE ENCROACHMENTS

**LEGAL DESCRIPTION**

LOT ONE (1), IN BLOCK TWO (2), OF WHITE OAK BEND, SECTION TWO (2), A SUBDIVISION IN HARRIS COUNTY, TEXAS, ACCORDING TO THE MAP OR PLAT THEREOF, RECORDED IN VOLUME 295, PAGE 99 OF THE MAP RECORDS OF HARRIS COUNTY, TEXAS.

THALIA PUENTE

**ADDRESS**

10703 BUFFALO BEND DRIVE



I DO HEREBY CERTIFY THAT THIS SURVEY WAS THIS DAY MADE ON THE GROUND OF THE PROPERTY LEGALLY DESCRIBED HEREON (OR ON ATTACHED SHEET), AND THERE ARE NO ENCROACHMENTS EXCEPT AS SHOWN, AND WAS DONE BY ME OR UNDER MY SUPERVISION, AND CONFORMS TO OR EXCEEDS THE CURRENT STANDARDS AS ADOPTED BY THE TEXAS BOARD OF PROFESSIONAL ENGINEERS AND LAND SURVEYORS.

JOB # 2112197

DATE 12-13-2021

GF# 21013330

**PRO-SURV**

P.O. BOX 1366, FRIENDSWOOD, TX 77549  
 PHONE: 281-996-1113 FAX: 281-996-0012  
 EMAIL: orders@prosurv.net  
 T.B.P.E.L.S. FIRM #10119300

ONLY SURVEY MAPS WITH THE SURVEYOR'S ORIGINAL SIGNATURE ARE GENUINE TRUE AND CORRECT COPIES OF THE SURVEYOR'S ORIGINAL WORK AND OPINION

© 2021 PRO-SURV - ALL RIGHTS RESERVED

**LEGEND** \* ITEMS THAT MAY APPEAR IN DRAWING BELOW

A.E. = AERIAL EASEMENT  
 B.L. = BUILDING LINE  
 B.S. = BEARS  
 C.F.# = CLERK'S FILE NUMBER  
 D.E. = DRAINAGE EASEMENT  
 E.E. = ELECTRIC EASEMENT  
 F.I.P. = FOUND IRON PIPE  
 F.L.R. = FOUND IRON ROD  
 F.N.D. = FOUND

M.P. = METAL POST  
 M.U.E. = MUNICIPAL UTILITY EASEMENT  
 P.A.E. = PERMANENT ACCESS EASEMENT  
 P.C. = POINT OF CURVATURE  
 P.C.C. = POINT OF COMPOUND CURVATURE  
 P.E. = POOL EQUIPMENT  
 P.O.S. = POINT OF COMMENCING  
 P.O.B. = POINT OF BEGINNING  
 P.P. = POWER POLE

P.R.C. = POINT OF REVERSE CURVATURE  
 P.T. = POINT OF TANGENCY  
 P.U.E. = PUBLIC UTILITY EASEMENT  
 S.I.R. = SET IRON ROD  
 S.S.E. = SANITARY SEWER EASEMENT  
 S.S.L.S.E. = STORM SEWER EASEMENT  
 U.S. = UNABLE TO SET  
 U.E. = UTILITY EASEMENT  
 W.L.E. = WATER LINE EASEMENT  
 W.P. = WOODEN POST  
 W.S.E. = WATER & SEWER EASEMENT  
 S.F.N.F. = SEARCHED FOR, NOT FOUND


--- = NOT TO SCALE

⊙ = GUY ANCHOR  
 ⊕ = POWER POLE  
 ⊖ = SERVICE DROP


⊙ = CONTROL MONUMENT  
 ⊙ = PROPERTY CORNER  
 --- = PROPERTY LINE  
 --- = EASEMENT LINE  
 --- = BUILDING SETBACK LINE  
 --- = BUILDING WALL

--- = WOODEN FENCE  
 --- = CHAIN LINK FENCE  
 --- = METAL FENCE  
 --- = WIRE FENCE  
 --- = VINYL FENCE  
 --- = OVERHEAD ELECTRIC POWER LINE

LINE TABLE		
LINE	BEARING	DISTANCE
L1	S 44°37'54" W	14.14'

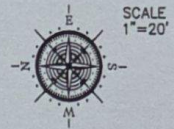

10703 BUFFALO BEND DRIVE  
 (50' R.O.W.)

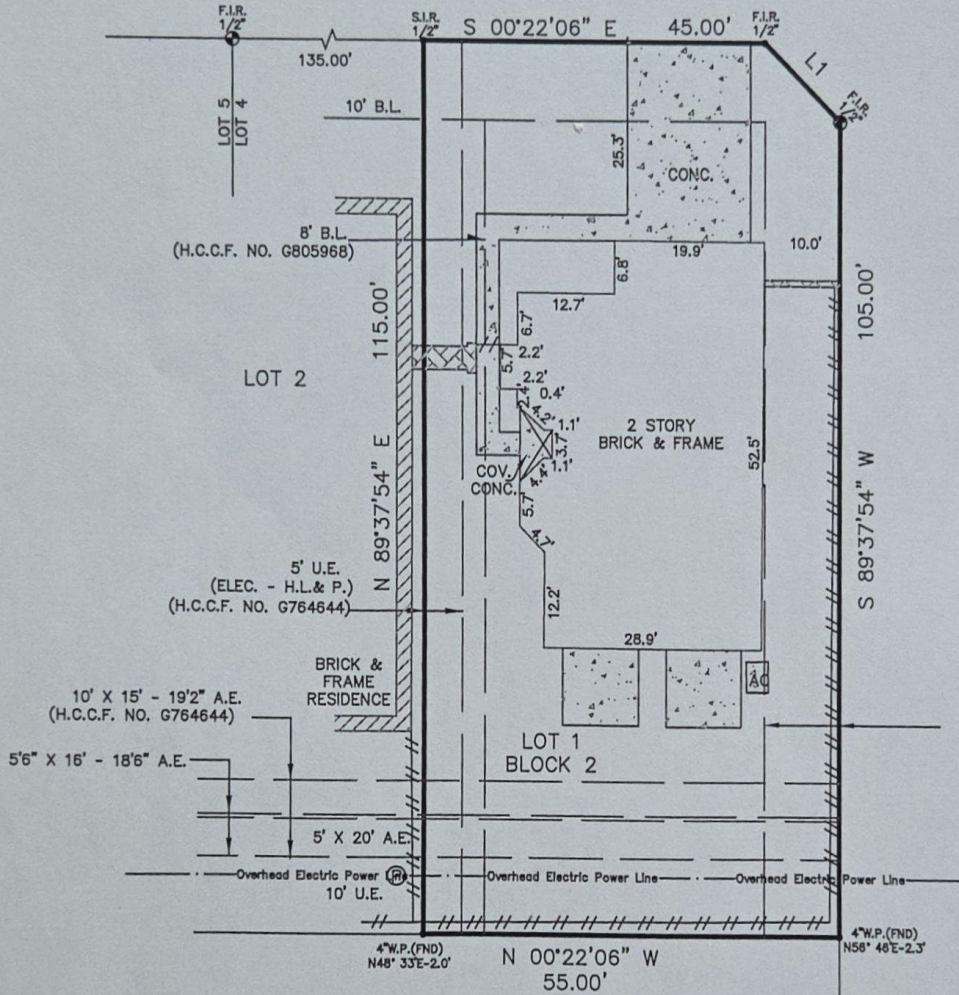

CRESCENT MOON DRIVE  
 (60' R.O.W.)  
 10' B.L.  
 (VOL. 305, PG. 44 H.C.M.R.)

UNRESTRICTED RESERVE "A"  
 CHELSEA PARK APARTMENTS  
 (VOL. 319, PG. 85 H.C.M.R.)

*[Signature]* 01/06/2022

Reviewed & Accepted by: \_\_\_\_\_ Date: \_\_\_\_\_

**NOTES:**  
 - BEARING BASIS: PLAT  
 - SUBJECT TO ANY AND ALL RECORDED AND UNRECORDED EASEMENTS  
 - SURVEYOR HAS NOT INDEPENDENTLY ABSTRACTED PROPERTY  
 - UNDERGROUND UTILITY INSTALLATIONS, UNDERGROUND IMPROVEMENTS, FOUNDATIONS AND/OR OTHER UNDERGROUND STRUCTURES WERE NOT LOCATED BY THIS SURVEY - THIS SURVEY IS CERTIFIED FOR THIS TRANSACTION ONLY, IT IS NOT TRANSFERABLE TO ADDITIONAL INSTITUTIONS OR SUBSEQUENT OWNERS  
 - SUBJECT TO RESTRICTIVE COVENANTS AS PER TITLE COMMITMENT  
 - SUBJECT TO ZONING AND BUILDING ORDINANCES ENFORCED BY LOCAL MUNICIPALITIES  
 - ZERO LINE SETBACK, ONE WALL OF THE BUILDING, CARPORT OR GARAGE SHALL BE LOCATED ON ONE SIDE LOT LINE ON INTERIOR LOTS. HOWEVER, THIS WALL SHALL NOT HAVE ANY WINDOWS, DOORS OR OTHER SUCH RELATED OPENINGS. THE OTHER WALL OF THE BUILDING, CARPORT OR GARAGE SHALL BE A MINIMUM OF 8 FEET TO AN INTERIOR LOT LINE OR 10 FEET TO AN EXTERIOR LOT LINE ON A CORNER LOT AS SET FORTH IN INSTRUMENT RECORDED UNDER HARRIS COUNTY CLERK'S FILE NO. 6805988  
 - AGREEMENT FOR UNDERGROUND ELECTRIC SERVICE WITH H.L.#, C.F. #0820392  
 - FENCES DO NOT FOLLOW PROPERTY LINES. NO ACCESS TO ADJOINING PROPERTIES TO CHECK FOR POSSIBLE ENCROACHMENTS

**LEGAL DESCRIPTION**  
 LOT ONE (1), IN BLOCK TWO (2), OF WHITE OAK BEND, SECTION TWO (2), A SUBDIVISION IN HARRIS COUNTY, TEXAS, ACCORDING TO THE MAP OR PLAT THEREOF, RECORDED IN VOLUME 295, PAGE 99 OF THE MAP RECORDS OF HARRIS COUNTY, TEXAS.

THALIA PUENTE ADDRESS 10703 BUFFALO BEND DRIVE



I DO HEREBY CERTIFY THAT THIS SURVEY WAS THIS DAY MADE ON THE GROUND OF THE PROPERTY LEGALLY DESCRIBED HEREON (OR ON ATTACHED SHEET), AND THERE ARE NO ENCROACHMENTS EXCEPT AS SHOWN, AND WAS DONE BY ME OR UNDER MY SUPERVISION, AND CONFORMS TO OR EXCEEDS THE CURRENT STANDARDS AS ADOPTED BY THE TEXAS BOARD OF PROFESSIONAL ENGINEERS AND LAND SURVEYORS.

JOB # 2112197  
 DATE 12-13-2021  
 GF# 21013330  
**PRO-SURV**  
 P.O. BOX 1368, FRIENDSWOOD, TX 77549  
 PHONE: 281-996-1113 FAX: 281-996-0012  
 EMAIL: orders@prosurv.net  
 T.B.P.E.L.S. FIRM #1019300  
 ONLY SURVEY MAPS WITH THE SURVEYOR'S ORIGINAL SIGNATURE ARE GENUINE TRUE AND CORRECT COPIES OF THE SURVEYOR'S ORIGINAL WORK AND OPINION  
 © 2021 PRO-SURV - ALL RIGHTS RESERVED

**LEGEND** \* ITEMS THAT MAY APPEAR IN \*  
DRAWING BELOW

A.E. = AERIAL EASEMENT  
B.L. = BUILDING LINE  
BRS = BEARS  
C.F.# = CLERK'S FILE NUMBER  
D.E. = DRAINAGE EASEMENT  
E.E. = ELECTRIC EASEMENT  
F.I.P. = FOUND IRON PIPE  
F.I.R. = FOUND IRON ROD  
FND. = FOUND

M.P. = METAL POST  
M.U.E. = MUNICIPAL UTILITY EASEMENT  
P.A.E. = PERMANENT ACCESS EASEMENT  
P.C. = POINT OF CURVATURE  
P.C.C. = POINT OF COMPOUND CURVATURE  
P.E. = POOL EQUIPMENT  
P.O.C. = POINT OF COMMENCING  
P.O.B. = POINT OF BEGINNING  
P.P. = POWER POLE


P.R.C. = POINT OF REVERSE CURVATURE  
P.T. = POINT OF TANGENCY  
P.U.E. = PUBLIC UTILITY EASEMENT  
S.I.R. = SET IRON ROD  
S.S.E. = SANITARY SEWER EASEMENT  
S.M.S.E. = STORM SEWER EASEMENT  
U.T.S. = UNABLE TO SET  
U.E. = UTILITY EASEMENT  
W.L.E. = WATER LINE EASEMENT  
W.P. = WOODEN POST  
W.S.E. = WATER & SEWER EASEMENT  
S.F.N.F. = SEARCHED FOR, NOT FOUND

- NOT TO SCALE  
⊕ = GUY ANCHOR  
⊙ = POWER POLE  
⊖ = SERVICE DROP


⊕ = CONTROL MONUMENT  
● = PROPERTY CORNER  
— = EASEMENT LINE  
— = BUILDING SETBACK LINE  
— = BUILDING WALL

— = WOODEN FENCE  
— = CHAIN LINK FENCE  
— = METAL FENCE  
— = WIRE FENCE  
— = VINYL FENCE  
— = OVERHEAD ELECTRIC POWER LINE

LINE TABLE		
LINE	BEARING	DISTANCE
L1	S 44°37'54" W	14.14'

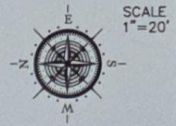

10703 BUFFALO BEND DRIVE  
(50' R.O.W.)

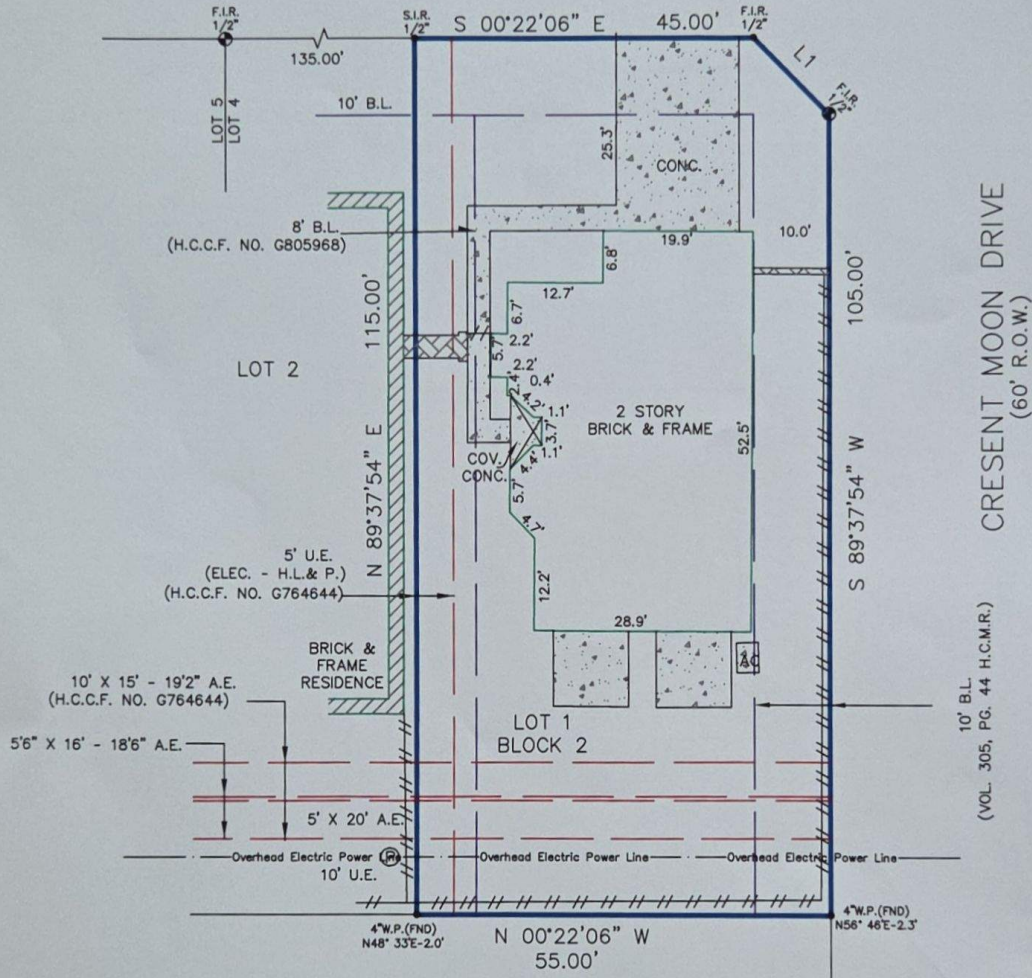

UNRESTRICTED RESERVE "A"  
CHELSEA PARK APARTMENTS  
(VOL. 319, PG. 85 H.C.M.R.)

Reviewed & Accepted by: \_\_\_\_\_

Date \_\_\_\_\_

Date \_\_\_\_\_

**NOTES:**

- BEARING BASIS: PLAT
- SUBJECT TO ANY AND ALL RECORDED AND UNRECORDED EASEMENTS
- SURVEYOR HAS NOT INDEPENDENTLY ABSTRACTED PROPERTY
- UNDERGROUND UTILITY INSTALLATIONS, UNDERGROUND IMPROVEMENTS, FOUNDATIONS AND/OR OTHER UNDERGROUND STRUCTURES WERE NOT LOCATED BY THIS SURVEY
- THIS SURVEY IS CERTIFIED FOR THIS TRANSACTION ONLY, IT IS NOT TRANSFERABLE TO ADDITIONAL INSTITUTIONS OR SUBSEQUENT OWNERS
- SUBJECT TO RESTRICTIVE COVENANTS AS PER TITLE COMMITMENT
- SUBJECT TO ZONING AND BUILDING ORDINANCES ENFORCED BY LOCAL MUNICIPALITIES
- ZERO LINE SETBACK, ONE WALL OF THE BUILDING, CARPORT OR GARAGE SHALL BE LOCATED ON ONE SIDE LOT LINE ON INTERIOR LOTS. HOWEVER, THIS WALL SHALL NOT HAVE ANY WINDOWS, DOORS OR OTHER SUCH RELATED OPENINGS. THE OTHER WALL OF THE BUILDING, CARPORT OR GARAGE SHALL BE A MINIMUM OF 8 FEET TO AN INTERIOR LOT LINE OR 10 FEET TO AN EXTERIOR LOT LINE ON A CORNER LOT AS SET FORTH IN INSTRUMENT RECORDED UNDER HARRIS COUNTY CLERK'S FILE NO. G805968
- AGREEMENT FOR UNDERGROUND ELECTRIC SERVICE WITH H.L.&P., C.F. #G829392
- FENCES DO NOT FOLLOW PROPERTY LINES. NO ACCESS TO ADJOINING PROPERTIES TO CHECK FOR POSSIBLE ENCROACHMENTS


**LEGAL DESCRIPTION**

LOT ONE (1), IN BLOCK TWO (2), OF WHITE OAK BEND, SECTION TWO (2), A SUBDIVISION IN HARRIS COUNTY, TEXAS, ACCORDING TO THE MAP OR PLAT THEREOF, RECORDED IN VOLUME 295, PAGE 99 OF THE MAP RECORDS OF HARRIS COUNTY, TEXAS.

THALIA PUENTE

**ADDRESS**

10703 BUFFALO BEND DRIVE

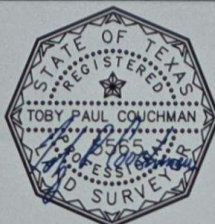

I DO HEREBY CERTIFY THAT THIS SURVEY WAS THIS DAY MADE ON THE GROUND OF THE PROPERTY LEGALLY DESCRIBED HEREON (OR ON ATTACHED SHEET), AND THERE ARE NO ENCROACHMENTS EXCEPT AS SHOWN, AND WAS DONE BY ME OR UNDER MY SUPERVISION, AND CONFORMS TO OR EXCEEDS THE CURRENT STANDARDS AS ADOPTED BY THE TEXAS BOARD OF PROFESSIONAL ENGINEERS AND LAND SURVEYORS.

JOB # 2112197

DATE 12-13-2021

GF# 21013330

**PRO-SURV**

P.O. BOX 1366, FRIENDSWOOD, TX 77549  
PHONE: 281-996-1113 FAX: 281-996-0012  
EMAIL: orders@prosurv.net  
T.B.P.E.L.S. FIRM #10119300

ONLY SURVEY MAPS WITH THE SURVEYOR'S ORIGINAL SIGNATURE ARE GENUINE TRUE AND CORRECT COPIES OF THE SURVEYOR'S ORIGINAL WORK AND OPINION

© 2021 PRO-SURV - ALL RIGHTS RESERVED