


GF NO. 9618241219 TITLE AGENCY
 ADDRESS: 4051 SHERWOOD STREET EAST
 KINGWOOD, TEXAS 77339
 BORROWER: L. MICHELE BOYD

LOT 395, BLOCK 20 SHERWOOD TRAILS, SECTION TWO

ACCORDING TO THE MAP OR PLAT THEREOF
 RECORDED IN VOLUME 284, PAGE 121 OF THE
 MAP RECORDS OF HARRIS COUNTY, TEXAS

SCALE: 1" = 30'

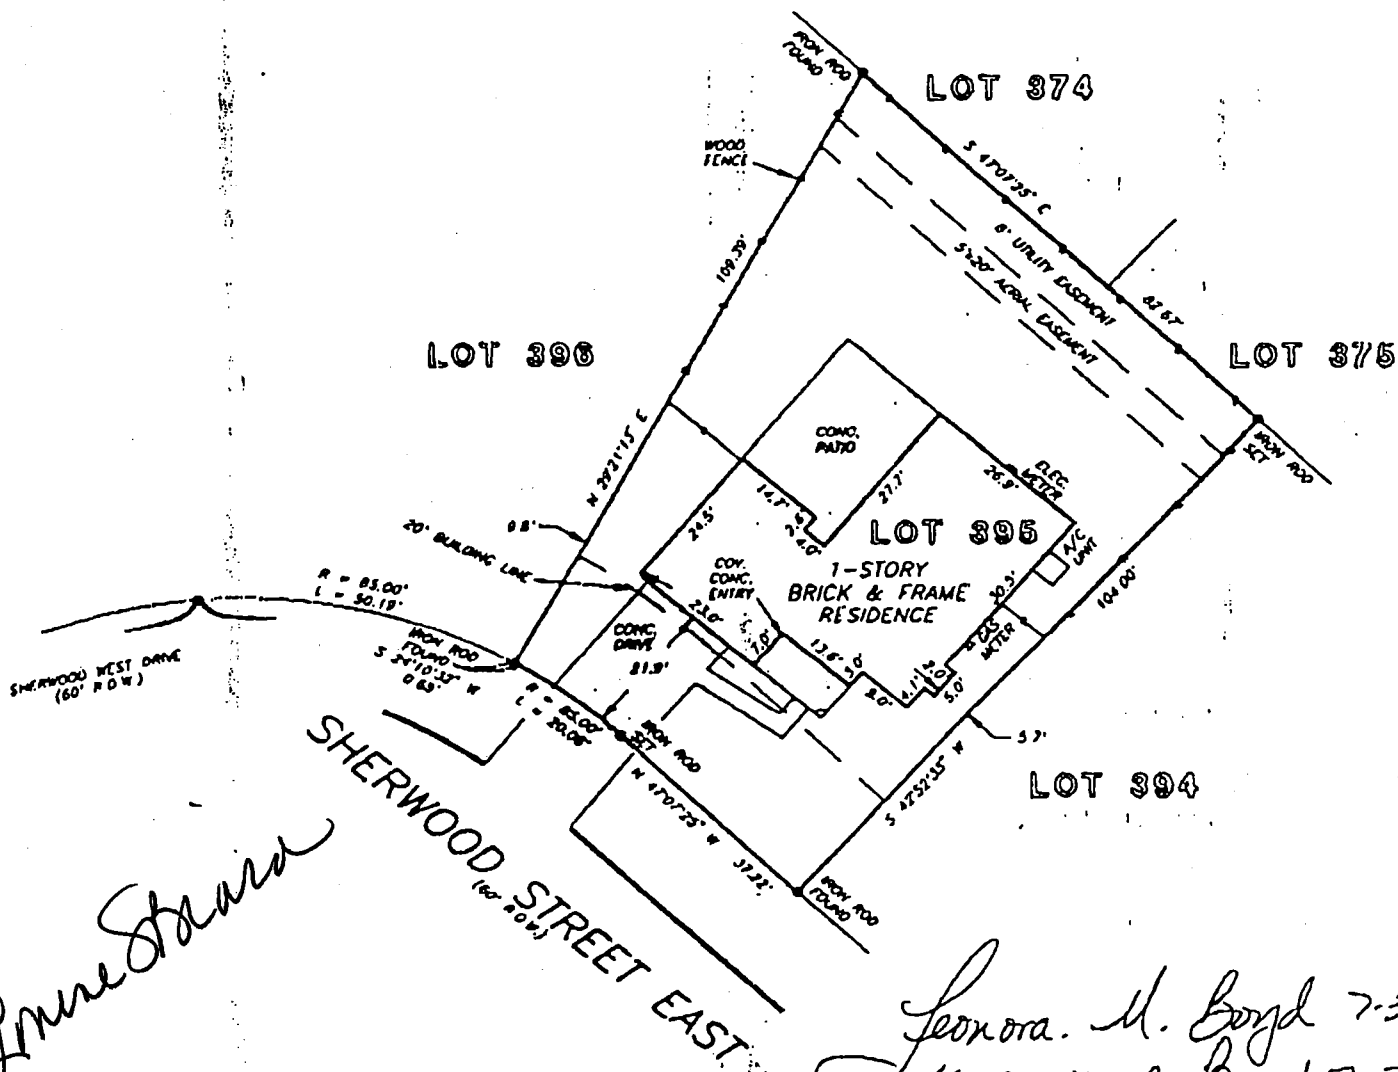

NOTE: IN THE EVENT THAT AUDIO AND VIDEO COMMUNICATION SERVICES ARE MADE AVAILABLE TO ANY LOTS BY MEANS OF AN UNDERGROUND COAXIAL CABLE SYSTEM THE COMPANY FURNISHING SUCH SERVICES AND FACILITIES SHALL HAVE A TWO FOOT WIDE EASEMENT ALONG AND CENTERED ON THE UNDERGROUND WIRE OR CABLE, WHEN AND AS INSTALLED, FROM THE UTILITY EASEMENT TO THE POINT OF CONNECTION ON THE PERMANENT IMPROVEMENT OR STRUCTURE, CONSTRUCTION OR TO BE CONSTRUCTED, UPON SAID LOTS, AS PER GF. NO. F838460


NOTE: AGREEMENT BY AND BETWEEN DEVELOPER AND M&P FOR INSTALLATION OF OVERHEAD/UNDERGROUND ELECTRICAL DISTRIBUTION SYSTEM. GF. NO. F88722.

THIS PROPERTY DOES NOT LIE WITHIN THE 100 YEAR FLOOD PLAIN AS ESTABLISHED BY THE U.S. DEPT. OF HOUSING & URBAN DEVELOPMENT.
 COMMUNITY/PANEL NO. 48201C 0060 G
 MAP REVISION: 9/28/90
 ZONE X

RECORD BEARING = VOL. 284, PG. 121

I HEREBY CERTIFY THAT THIS SURVLY WAS MADE ON THE GROUND, THAT THIS PLAT CORRECTLY REPRESENTS THE FACTS FOUND AT THE TIME OF SURVEY AND THAT THIS PROFESSIONAL SERVICE CONFORMS TO THE CURRENT TEXAS SOCIETY OF PROFESSIONAL SURVEYORS STANDARDS AND SPECIFICATIONS FOR A CATEGORY 1A CONDITION II SURVEY.

BARRY WHITE
 PROFESSIONAL LAND SURVEYOR
 NO. 4189
 DRAWING NO. 96-1607
 JULY 29, 1996

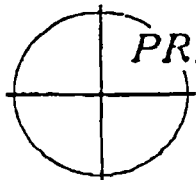


PRECISION SURVEYORS

PROFESSIONAL LAND SURVEYS

1-800-LANDSURVEY 713-496-1586
 1-800-526-3787 FAX 713-496-1867

14780 MEMORIAL DRIVE SUITE 100 HOUSTON, TEXAS 77079

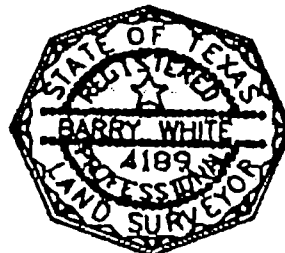

DRAWN BY: NH