


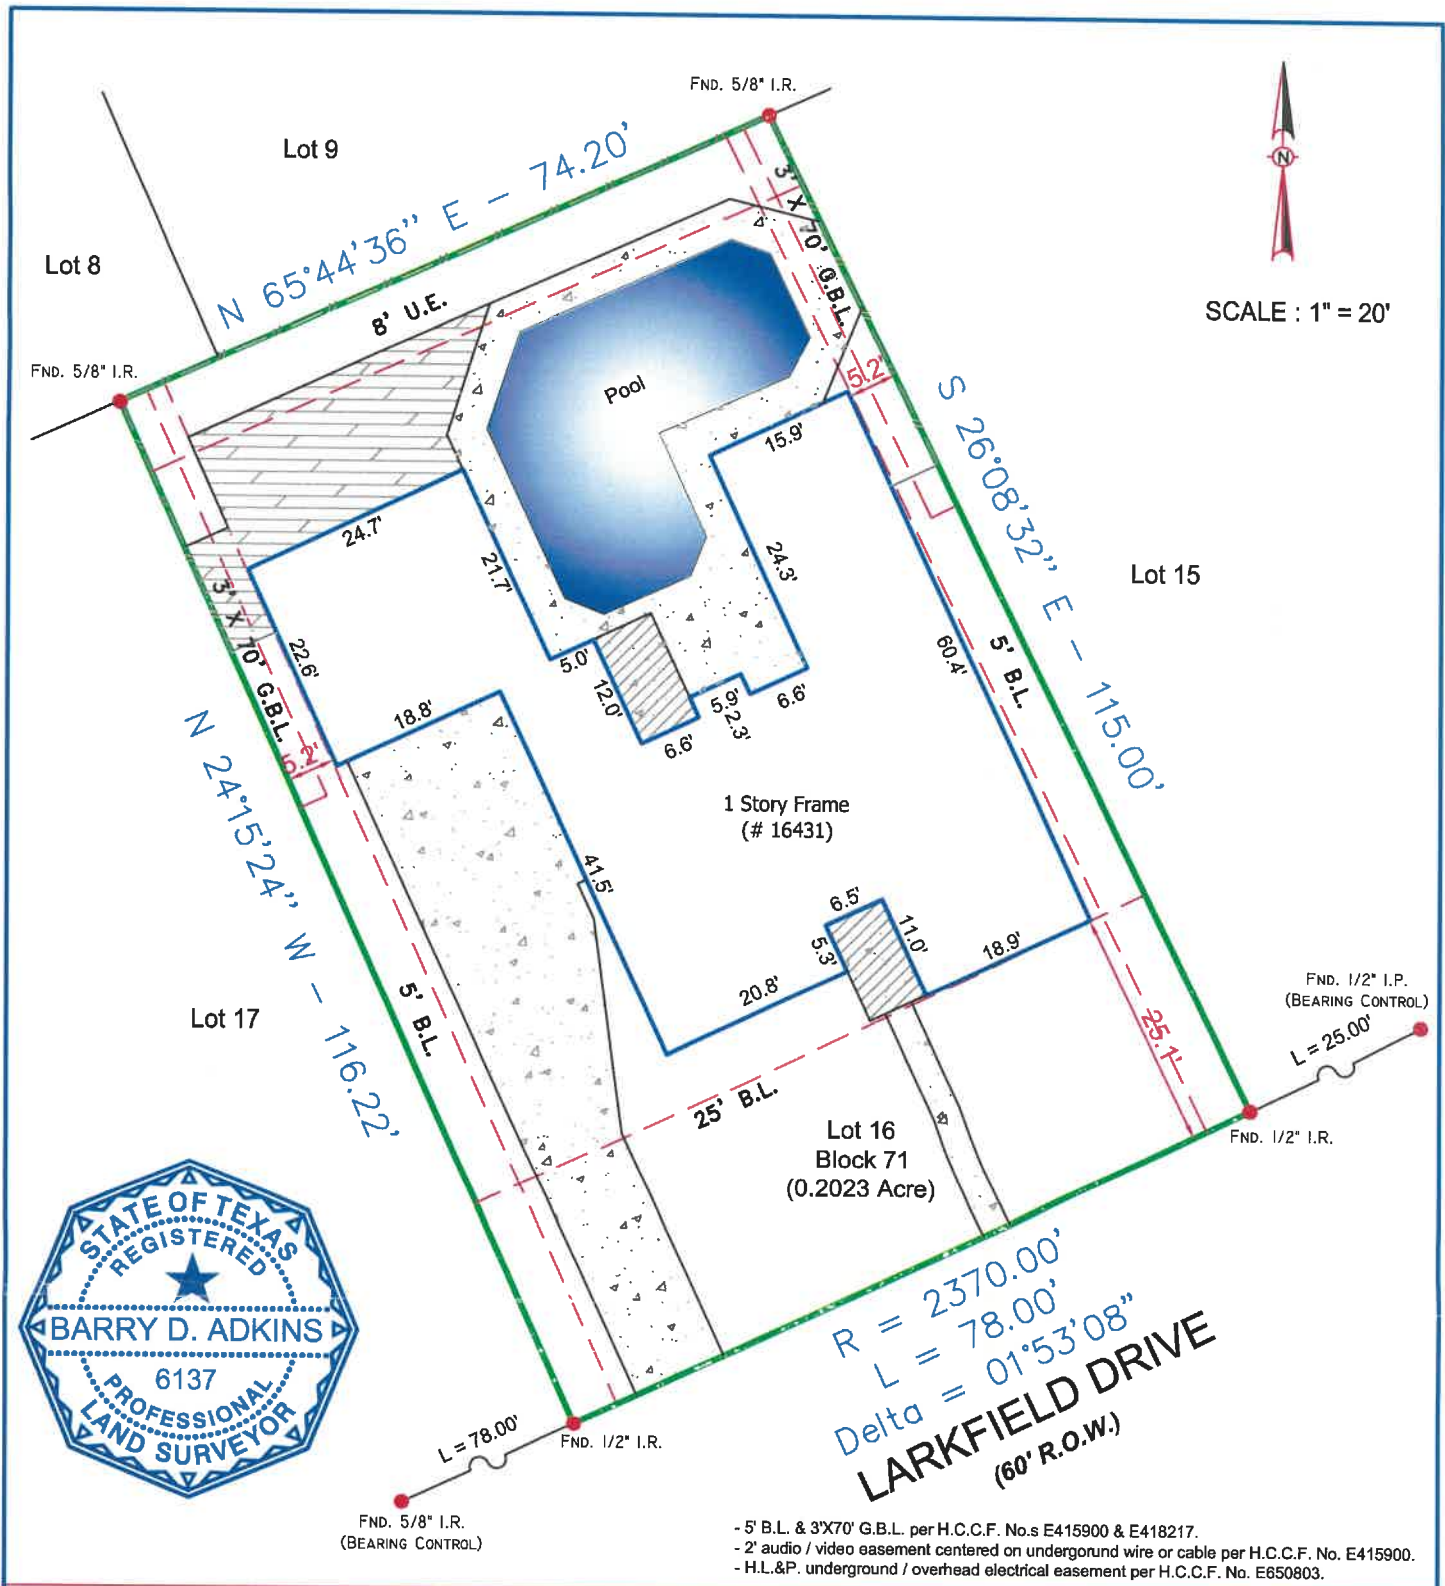

Notes :

- Basis for Bearings: Record plat.
- All abstracting done by title company.
- All B.L.'s & U.E.'s taken from recorded plat unless otherwise noted.
- Dimension ties from improvements to property lines are calculated and should NOT be relied upon for construction and/or removal of any improvements including fences.
- Building dimensions may not be used to calculate square footage.
- This property subject to any and all recorded and unrecorded easements. Surveyor has made no investigation or independent search for easements of record, encumbrances, restrictive covenants or ownership title evidence.

I hereby certify that this survey under my supervision was this day made on the ground and that this plat correctly represents the property legally described hereon (or on attached sheet). That the facts found at the time of this survey show the improvements and that there are no visible encroachments apparent on the ground, except as shown, to the best of my knowledge, surveyed 03-07-13.

BARRY D. ADKINS, R.P.L.S. No. 6137
This survey is certified for this transaction only, is not transferable to additional institutions or subsequent owners. If this survey does not bear an original BLUE seal it is invalid and should not be relied upon for any purpose.

LOT: 16 BLOCK: 71 SUBDIVISION: BROOK FOREST

RECORDATION: VOLUME 220, PAGE 66 OF THE MAP RECORDS

TITLE COMPANY: SOUTH LAND TITLE COMPANY G.F.#: CL1315748

PROPOSED BORROWER: DAVID LAW

ADDRESS: 16431 LARKFIELD DRIVE CITY: HOUSTON ZIP CODE: 77059

COUNTY: HARRIS STATE: TEXAS

LEGEND :

- U.E. = Utility Easement
- D.E. = Drainage Easement
- B.L. = Building Line
- G.E. = Guy Easement
- I.R. = Iron Rod
- I.P. = Iron Pipe
- P.I.P. = Pinch Iron Pipe
- P.P. = Power Pole
- Strm.S.E. = Storm Sewer Easement
- San.S.E. = Sanitary Sewer Easement
- H.C.C.F.No. = Harris County Clerk File Number

Legend symbols: Wood Fence, Chain Link, Barbed Wire, Wrought Iron, Overhead Powerline, Power Pole, Manhole, Water Meter.

This property appears to be OUT of the 100 year flood plain, & in insurance rate map zone X, as per map 48201C1080 L Dated : 06-18-07.

This determination to be used for flood insurance rate purposes ONLY and is NOT to be relied upon for ANY other purpose. Surveyor makes no representation as to whether property may Flood.



DaRam Engineers, Inc.
5420 Dashwood, Suite 206
Houston, Texas 77061
(713) 528-1552 * FAX (713) 529-8997

Project #: S201377059-Larkfield16431
SURVEYED BY: WW
DRAWN BY: JB