PERRY HOMES

2267W

2,267 SQ. FT. :: 1 FLOOR :: 4 BED :: 2 BATH :: 2 GARAGE

FIRST FLOOR

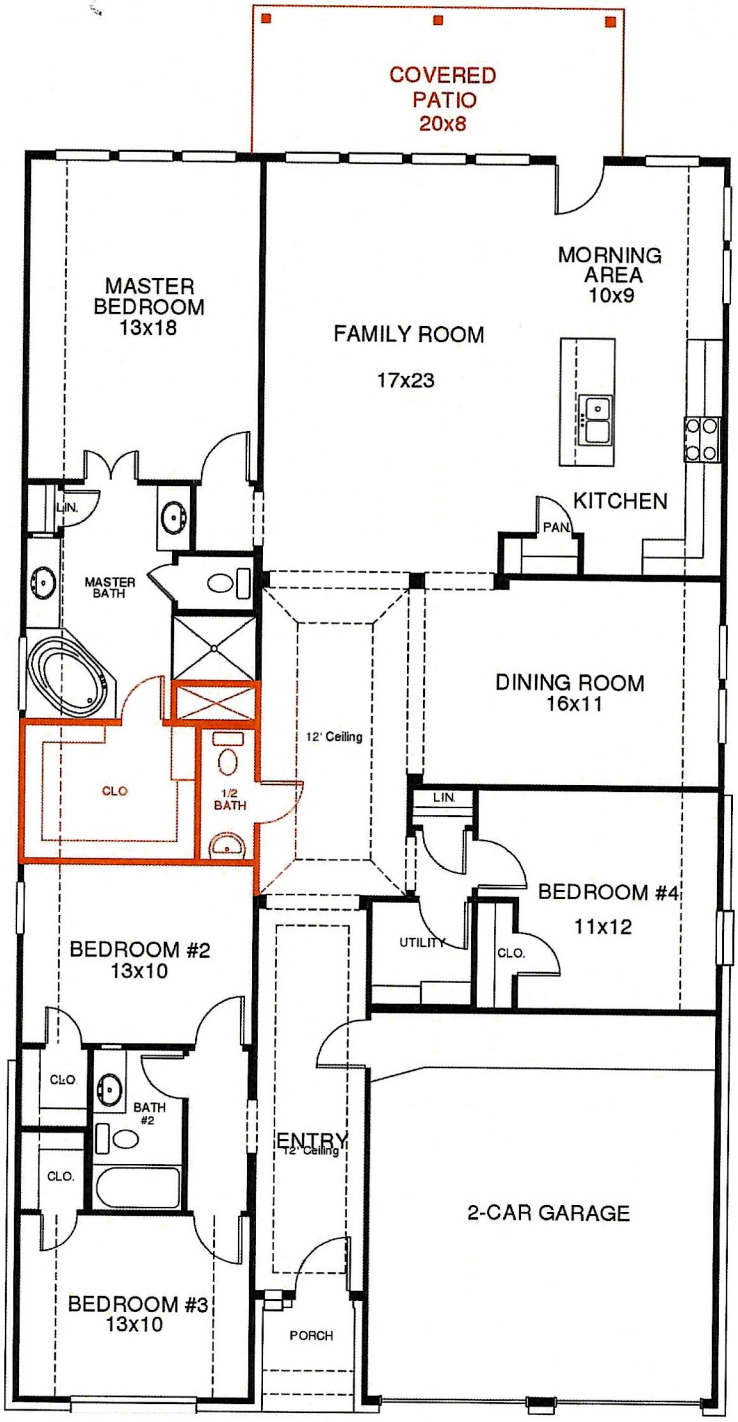

Please call 1-800-247-3779 or contact a Sales Professional in a Perry Homes Sales Center with any questions.

This design, as originally designed and prior to any personalization you make, is estimated to yield approximately the number of square feet shown above. All dimensions are approximate. Square footage may vary based on as-built dimension, configurations, plan options and/or the method of calculation.

Designs are not-to-scale, and are conceptual illustrations that may differ from constructions plans or completed improvements. A design may depict features not available on all homesites or in all communities. This rendering if the property of Perry Homes, LLC. Any reproduction or exhibition is strictly prohibited.

© Perry Homes, LLC 2019

For more information (including office hours & driving directions), visit our website at www.PERRYHOMES.com