LEGEND

★CITY ORDINANCES
★★RESTRICTIVE COVENANTS
★★★BUILDER GUIDELINES
( ) RECORD INFORMATION

I.R. = IRON ROD
I.P. = IRON PIPE
P.L. = PROPERTY LINE
U.E. = UTILITY EASEMENT

FND. = FOUND
FNC. = FENCE
P.U.E. = PUBLIC UTILITY ESMT.
P.A.E. = PERMANENT ACCESS ESMT.

M.U.E. = MUNICIPAL UTILITY ESMT.
S.S.E. = SANITARY SEWER ESMT.
W.L.E. = WATERLINE EASEMENT
R.O.W. = RIGHT-OF-WAY

CONCRETE | COVERED | SOD | BRICK | A/C PAD | E ELEC. BOX | U UTIL. PED. | MH MANHOLE | WATER METER

IRON FENCE
WIRE FENCE
WOOD FENCE
CHAIN LINK FENCE
BUILDING LINE (B.L.)
EASEMENT LINE
AERIAL EASEMENT (A.E.)

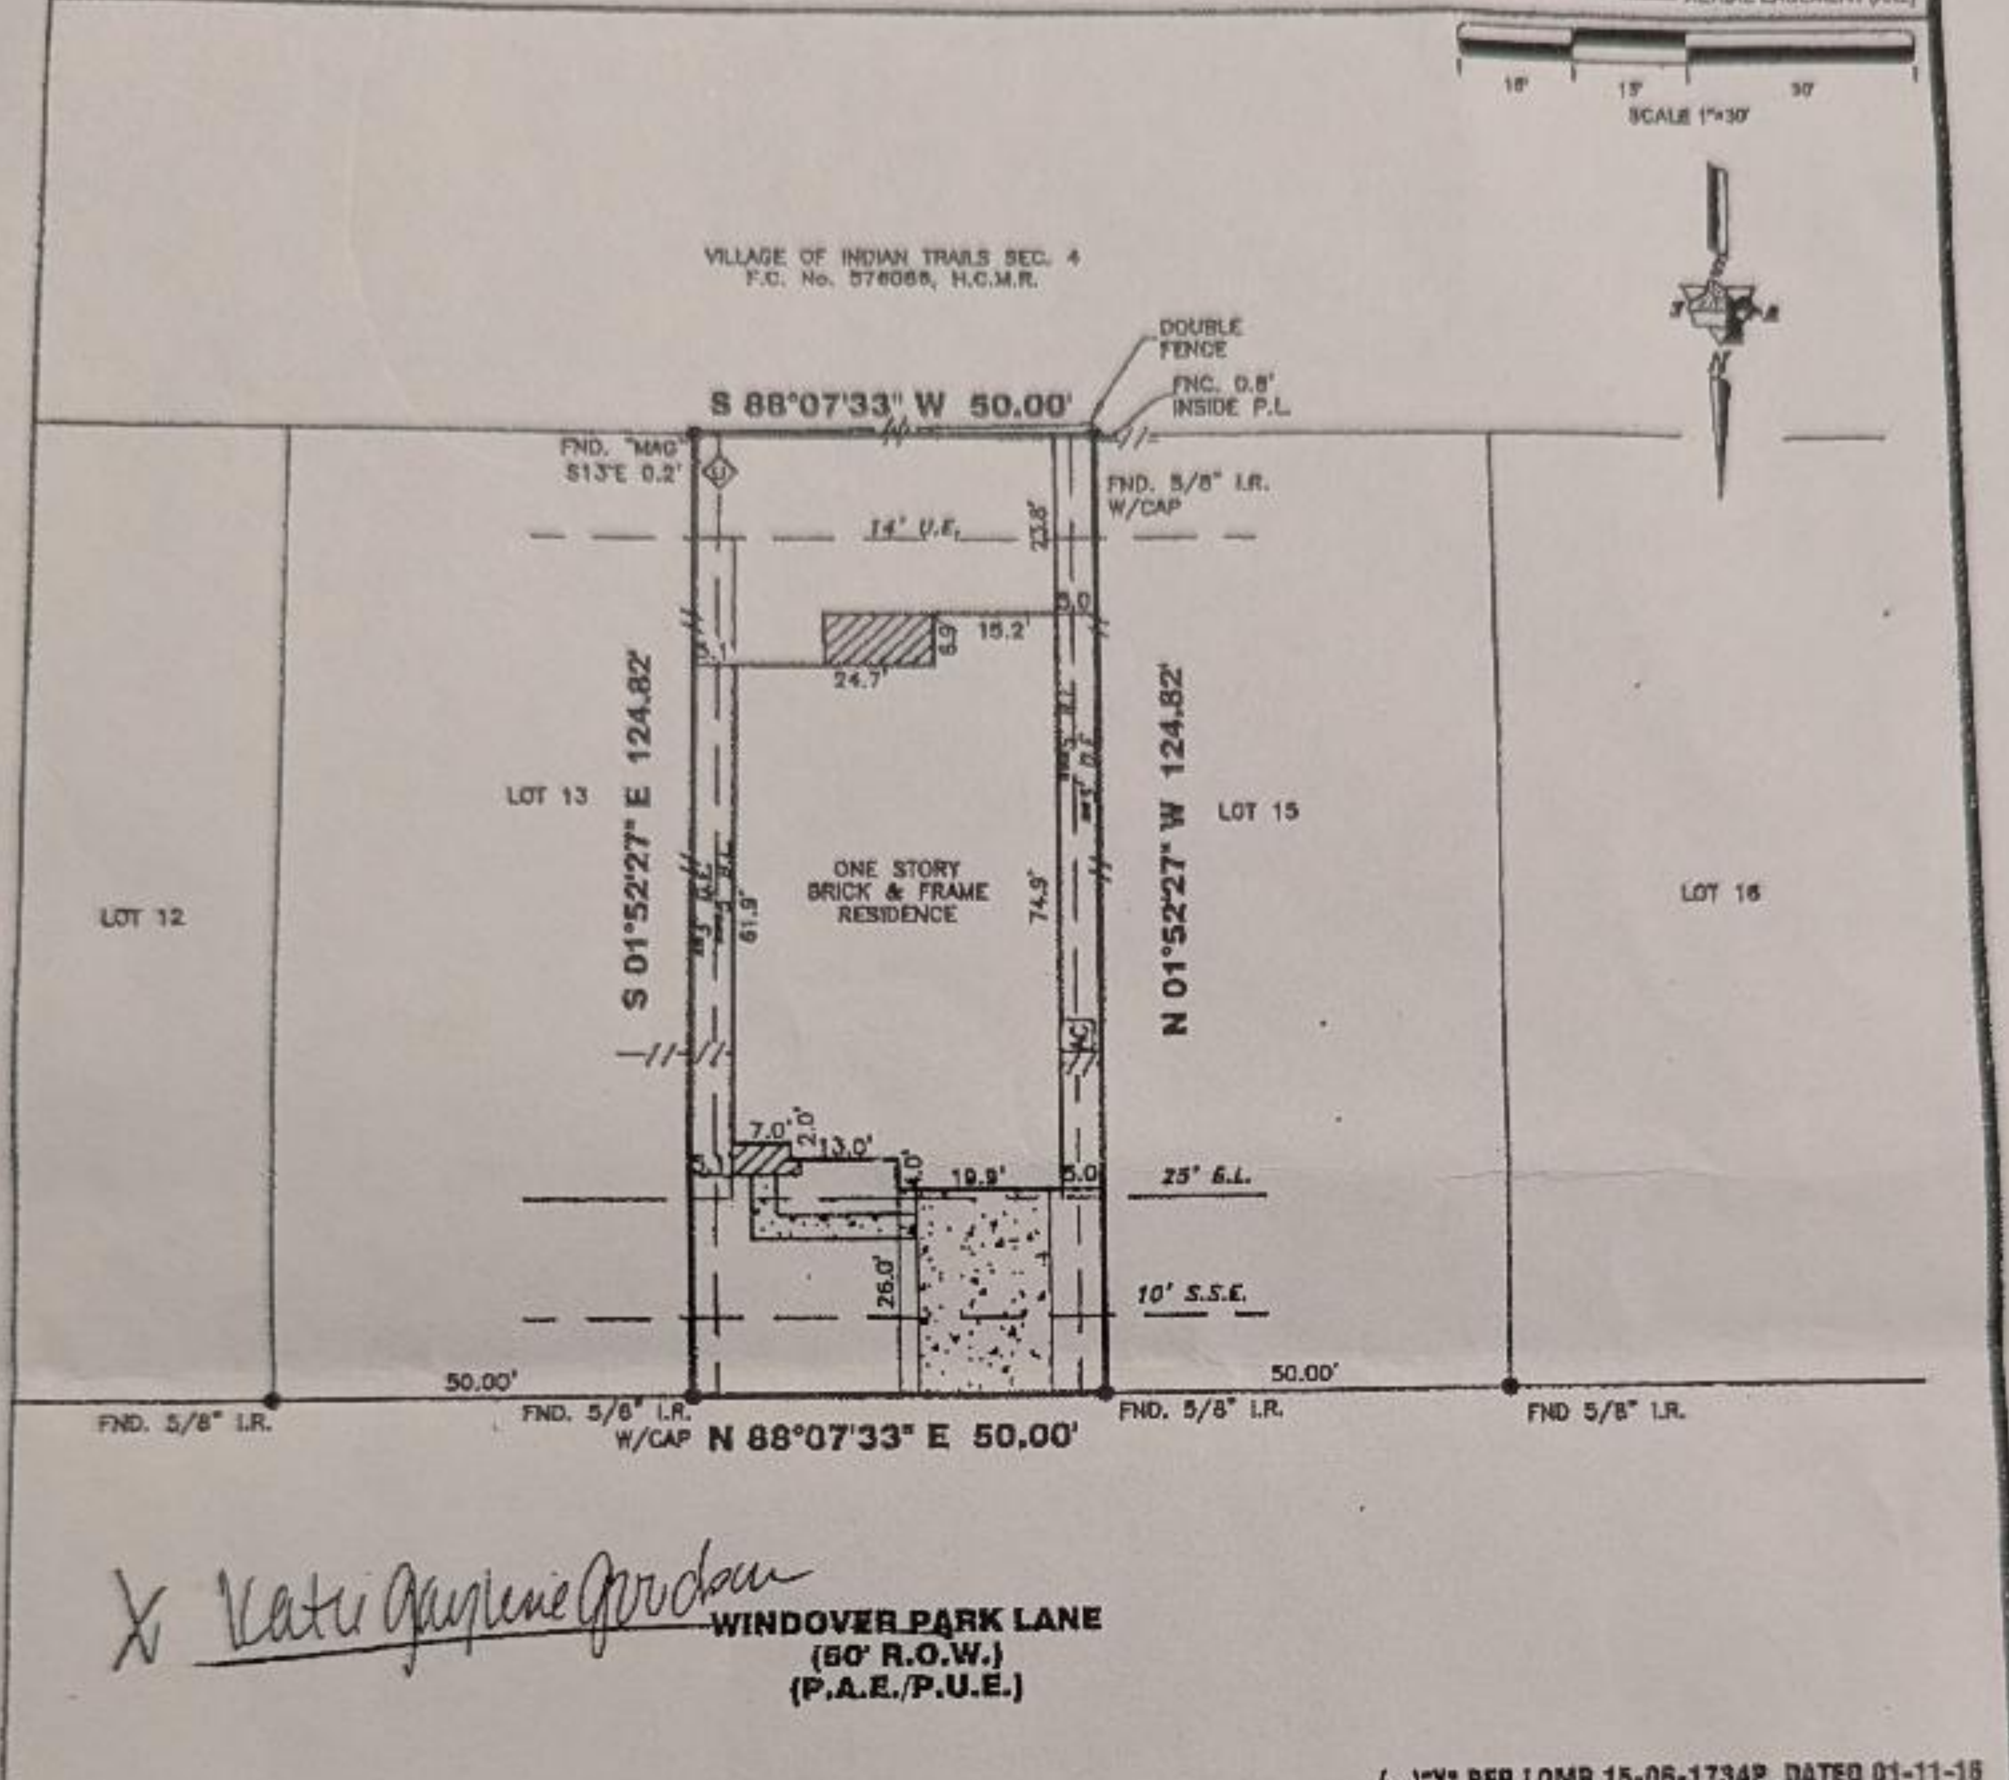

X Katie Gaylene Goodson

(~)"X" PER LOMR 15-06-1734P, DATED 01-11-16

14023 WINDOVER PARK LANE

PROPERTY INFORMATION

LOT 14 BLOCK 1

SUBDIVISION:
ENCLAVE AT NORTHPOINTE SEC 7

RECORDING INFO:
FILM CODE NO. 681667, MAP RECORDS, HARRIS COUNTY, TEXAS

BORROWER:
KATIE GAYLENE GOODSON

TITLE CO.
ALAMO TITLE COMPANY

G.F.# PTH1807527 G.F. DATE: 4/23/18

SURVEYED FOR:
K. HOVNANIAN HOMES OF HOUSTON, II, L.L.C.

DRAWING INFORMATION

TRI-TECH JOB NO: BH2010-18
CLIENT JOB NO:
DRAWN BY: SA
BEARING BASE: REFERRED TO PLAT NORTH
FIELD DATE: 05-11-18

FLOOD INFORMATION

F.I.R.M. NO: 48201C PANEL: 0220L
REVISED DATE: 06-18-07 ZONE: (~)"X"

FLOOD INFORMATION PROVIDED HEREON IS BASED ON SCALING THE LOCATION OF THE SUBJECT TRACT ON THE FLOOD INSURANCE RATE MAPS. THE INFORMATION SHOULD BE USED TO DETERMINE FLOOD INSURANCE RATES ONLY AND IS NOT INTENDED TO IDENTIFY SPECIFIC FLOODING CONDITIONS. WE ARE NOT RESPONSIBLE FOR THE F.I.R.M.'S ACCURACY. FLOOD INFORMATION IS SUBJECT TO LETTER OF MAP CHANGES.

NOTES:

ALL EASEMENTS AND BUILDING LINES SHOWN ARE PER THE RECORDED PLAT UNLESS OTHERWISE NOTED.

ALL ROD CAPS ARE STAMPED "BENCHMARK ENGR", UNLESS OTHERWISE NOTED.

SUBJECT TO A DRAINAGE EASEMENT 15' ON EACH SIDE OF THE CENTERLINE OF ALL NATURAL DRAINAGE COURSES IN THE ADDITION AS SHOWN ON RECORDED PLAT OF SAID ADDITION.

RESTRICTIVE COVENANTS AND EASEMENTS AS DEFINED PER FILM CODE NO. [illegible], H.R.M.C.TX.; H.C.C. FILE NOS. [illegible]

C.O.H. ORDINANCE [illegible] PER H.C.C.F. # [illegible] AND C.O.H. ORDINANCE [illegible] PER H.C.C.F.# [illegible] AND AMENDED BY C.O.H. ORDINANCE [illegible].

PROPERTY SUBJECT TO RECORDED RESTRICTIONS, REGULATIONS, & ORDINANCES IF ANY.

ABSTRACT INFORMATION PROVIDED HEREON IS BELIEVED TO BE SUFFICIENT AND CORRECT BY THE UNDERSIGNED SURVEYOR. THIS SURVEY DOES NOT CONSTITUTE A TITLE SEARCH BY THE SURVEYOR. THE ENCUMBRANCES OF RECORD, AS REFLECTED ON THIS SURVEY ARE BASED ON THE RECORDED MAP, PLAT AND/OR DEEDS IN CONJUNCTION WITH TITLE INFORMATION OBTAINED FROM THE TITLE REPORT LISTED HEREON.

ALL BUILDING LINES, RECORDED EASEMENTS, UNRECORDED EASEMENTS, BUILDING RESTRICTIONS (DEED RESTRICTIONS, ETC.) AND ZONING ORDINANCES (INCLUDING CITY OF HOUSTON), IF ANY, THAT AFFECT SUBJECT PROPERTY SHOULD BE VERIFIED.

THIS SURVEY DOES NOT ADDRESS ANY EAVES, GUTTERS OR OTHER OVERHANGING STRUCTURE FEATURES, WHICH MAY PROTRUDE OVER BOUNDARY, EASEMENT AND/OR BUILDING LINES, UNLESS OTHERWISE SHOWN HEREON.

REVISIONS

DATE	REASON	BY
05-13-18	FORM	OS
9/21/18	FINAL	JVG

TRI-TECH
SURVEYING COMPANY, L.P.
10401 WESTOFFICE DR.
HOUSTON, TEXAS 77042
PH: 713-667-0800
www.tritechtx.com TBPLS #10115900

CERTIFICATION

I, the undersigned registered professional land surveyor, do hereby state that the plat shown hereon represents a boundary survey made on the ground under my supervision of the tract or parcel of land, according to the map or plat thereof, indicated hereon.

THIS SURVEY IS VALID FOR THIS TRANSACTION ONLY.
THIS SURVEY IS INVALID WITHOUT THE ORIGINAL EMBOSSED SURVEYORS SEAL AND SIGNATURE.

© 2018 TRI-TECH SURVEYING COMPANY, L.P.

STATE OF TEXAS REGISTERED MARK S. BROWN 5553 PROFESSIONAL LAND SURVEYOR

09/24/2018
SURVEYOR REGISTRATION