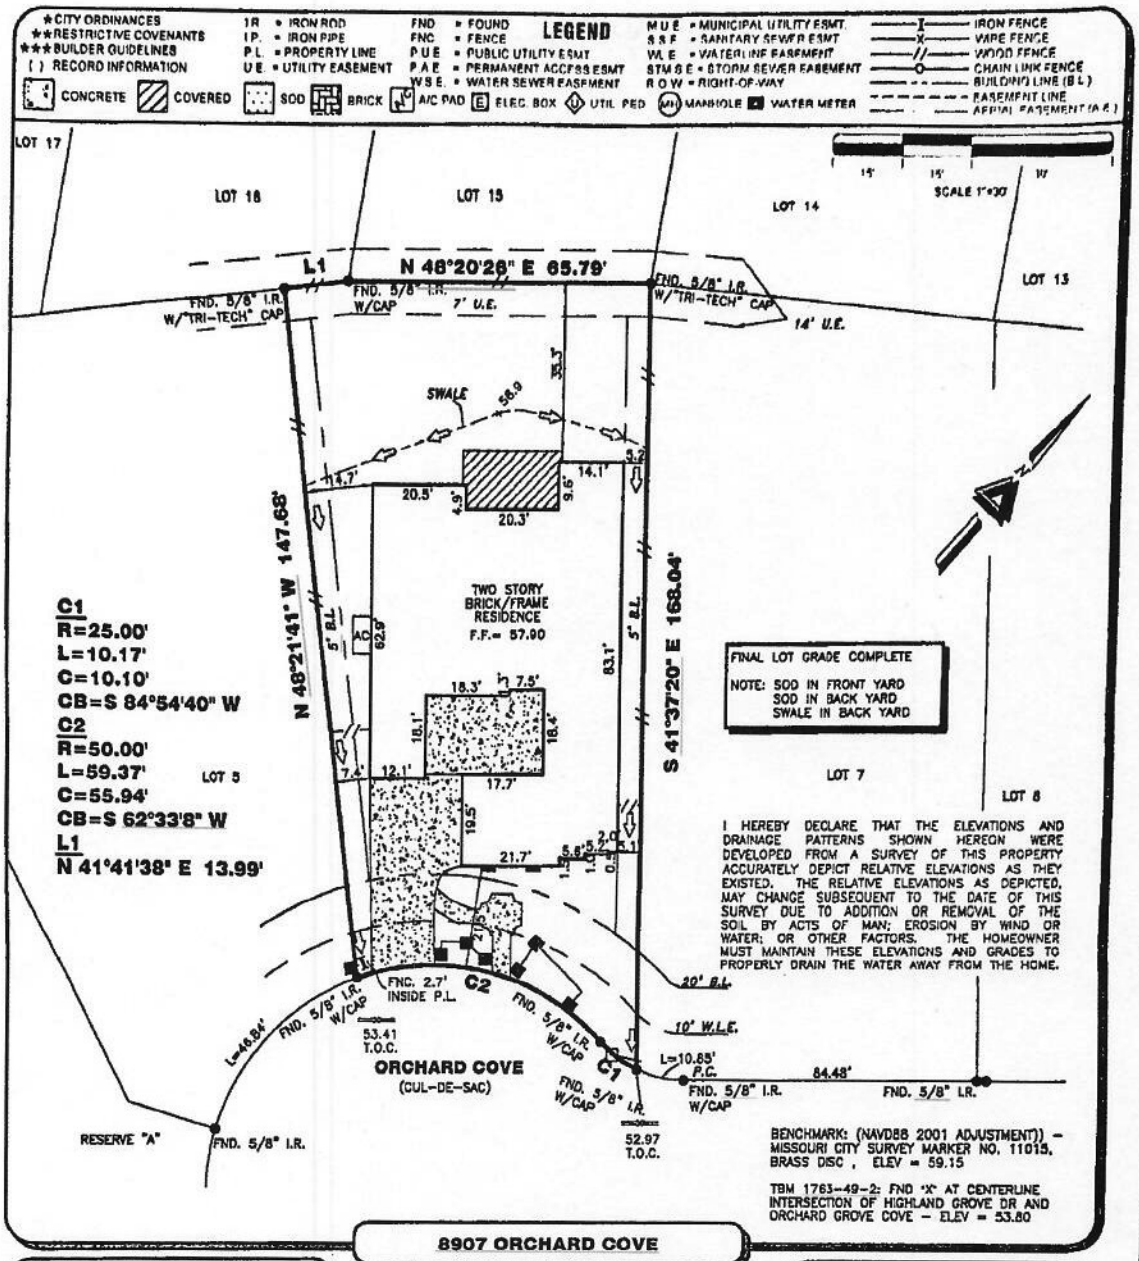

8907 ORCHARD COVE

PROPERTY INFORMATION

LOT 6 BLOCK 1

SUBDIVISION:
SIENNA SECTION 19

RECORDING INFO:
PLAT NO. 20220007, PLAT RECORDS, FORT BEND COUNTY, TEXAS

BORROWER:
ROBYN P. GARCIA

TITLE CO.
CHICAGO TITLE/EXECUTIVE TITLE CO., LTD.

G.F.# ETH2302583 G.F. DATE: 09-17-23

SURVEYED FOR:
PERRY HOMES, LLC

DRAWING INFORMATION

TRI-TECH JOB NO: Y38353-23
CLIENT JOB NO: N/A
DRAWN BY: PV
BEARING BASE: REFERRED TO PLAT NORTH
FIELD DATE: 04-10-23

FLOOD INFORMATION

F.I.R.M. NO: 48157C PANEL: 0435L
REVISED DATE: 04-02-14 ZONE: "X-SHADED"

FLOOD INFORMATION PROVIDED HEREON IS BASED ON SCALING THE LOCATION OF THE SUBJECT TRACT ON THE FLOOD INSURANCE RATE MAPS. THE INFORMATION SHOULD BE USED TO DETERMINE FLOOD INSURANCE RATES ONLY AND IS NOT INTENDED TO IDENTIFY SPECIFIC FLOODING CONDITIONS. WE ARE NOT RESPONSIBLE FOR THE F.I.R.M.'S ACCURACY. FLOOD INFORMATION IS SUBJECT TO LETTER OF MAP CHANGES

NOTES:

ALL EASEMENTS AND BUILDING LINES SHOWN ARE PER THE RECORDED PLAT UNLESS OTHERWISE NOTED.

RESTRICTIVE COVENANTS AND EASEMENTS AS DEFINED PER PLAT NO 20220007, F.B.P.R.O.P.R., F.B.C.C. FILE NOS. 2037103, 2011104698, 2011137236, 2011507779, 2012002208, 2015008419, 2015008465, 2015009503, 2015009533, 2015009777, 2015031778, 2015039809, 2015033313, 2015049439, 2015057584, 2015120594, 2015120651, 2016031808, 2016061808, 2016061840, 2016061911, 2016112900, 2016122801, 2016122862, 2016126115, 2016126118, 2016126142, 2017045042, 2019029028, 2019043415, 2019043417, 2019043418, 2019043419, 2019043420, 2019043543, 2019053033, 2019058053, 2019059532, 2019062036, 2019063417, 2020070062, 2020070080, 2020117408, 2020137458, 2020177498, 2020177470, 2021014468, 2021014469, 2021014470, 2021035335, 2021086719, 2021086723, 2021086724, 2021086725, 2021086726, 2021086736, 2021086745, 2021086746, 2021086747, 2021089533, 2021104188, 2021144198, 2021144199, 2021144191, 2021144315, 2021144317, 2021144361, 2021144362, 2021144363, 2021144364, 2021145133, 2021145234, 2021145853, 2021153067, 2021153068, 2021153069, 2021153070, 2021153074, 2021219038, 2022014809, 2022022331, 2022022741, 2022022742, 2022022743.

ALL ROD CAPS ARE STAMPED "CBI PARTNERS", UNLESS OTHERWISE NOTED.

SUBJECT TO A DRAINAGE EASEMENT 30' ON EACH SIDE OF THE CENTERLINE OF ALL NATURAL DRAINAGE COURSES IN THE ADDITION AS SHOWN ON RECORDED PLAT OF SAID ADDITION.

C.O.H. ORDINANCE 80-1878 PER H.C.C.F. # N-253888 AND C.O.H. ORDINANCE 80-1910 PER H.C.C.F.# M-537873 AND AMENDED BY C.O.H. ORDINANCE 1989-362.

PROPERTY SUBJECT TO RECORDED RESTRICTIONS, REGULATIONS, & ORDINANCES IF ANY.

ABSTRACT INFORMATION PROVIDED HEREON IS BELIEVED TO BE SUFFICIENT AND CORRECT BY THE UNDERSIGNED SURVEYOR. THIS SURVEY DOES NOT CONSTITUTE A TITLE SEARCH BY THE SURVEYOR. THE ENCUMBRANCES OF RECORD, AS REFLECTED ON THIS SURVEY ARE BASED ON THE RECORDED MAP, PLAT AND/OR DEEDS IN CONJUNCTION WITH TITLE INFORMATION OBTAINED FROM THE TITLE REPORT LISTED HEREON.

ALL BUILDING LINES, RECORDED EASEMENTS, UNRECORDED EASEMENTS, BUILDING RESTRICTIONS (DEED RESTRICTIONS, ETC.) AND ZONING ORDINANCES (INCLUDING CITY OF MISSOURI CITY) IF ANY, THAT AFFECT SUBJECT PROPERTY SHOULD BE VERIFIED.

THIS SURVEY DOES NOT ADDRESS ANY EAVES, GUTTERS OR OTHER OVERHANGING STRUCTURE FEATURES, WHICH MAY PROTRUDE OVER BOUNDARY, EASEMENT AND/OR BUILDING LINES, UNLESS OTHERWISE SHOWN HEREON.

REVISIONS

DATE	REASON	BY
10-06-23	FINAL	EL

TRI-TECH
SURVEYING COMPANY, L.P.
10401 WESTOFFICE DR.
HOUSTON, TEXAS 77042
PH: 713-667-0800
www.tritechtx.com TBPLS #10115900

CERTIFICATION

I, the undersigned registered professional land surveyor, do hereby state that the plat shown hereon represents a boundary survey made on the ground under my supervision of the tract or parcel of land, according to the map or plat thereof, indicated hereon.

THIS SURVEY IS VALID FOR THIS TRANSACTION ONLY

© 2023 TRI-TECH SURVEYING COMPANY, L.P.

10/09/2023

STATE OF TEXAS REGISTERED MARK S. BROWN 5553 PROFESSIONAL LAND SURVEYOR

SURVEYOR REGISTRATION

Oct 09,2023-2:02pm C:\2023\Perry Homes (Y)\Y38353-23.dwg