NOTICE OF INFORMATION FROM OTHER SOURCES

USE OF THIS FORM BY PERSONS WHO ARE NOT MEMBERS OF THE TEXAS ASSOCIATION OF REALTORS®, INC. IS NOT AUTHORIZED.

©Texas Association of REALTORS®, Inc. 2008

To: _____

_____

From: **SERHNAT. Texas, LLC** (Broker)

Property Address: **3114 Rimrock Dr, Missouri City, TX 77459**

Date: **November 10, 2026**

(1) Broker obtained the attached information, identified as **FBISD School Attendance Boundaries** _____, from **https://www.fortbendisd.gov/departments/collaborative-communities/long-range-boundry-planning-and-enrollment-management** _____,

(2) Broker has relied on the attached information and does not know and has no reason to know that the information is false or inaccurate except: _____

(3) **Broker does not warrant or guarantee the accuracy of the attached information. Do not rely on the attached information without verifying its accuracy.**

SERHNAT. Texas, LLC
Broker

By: _____
Steven Kinne

Receipt of this notice is acknowledged by:

_____
Signature Date

_____
Signature Date

Serhant Texas, LLC, 5718 Westheimer Rd #1000 Houston TX 77057 Phone: 2816103625 Fax: 3114 Rimrock Dr
Steven Kinne
Produced with Lone Wolf Transactions (zipForm Edition) 231 Shearson Cr. Cambridge, Ontario, Canada N1T 1J5 www.lwolf.com

FBISD
INSPIRE • EQUIP • IMAGINE

NEWS RELEASE

Communications@fortbendisd.gov | 281.634.1100

Fort Bend ISD Board of Trustees Approves Secondary Boundary Changes

FORT BEND ISD (October 5, 2026) - The Fort Bend ISD (FBISD) Board of Trustees approved secondary attendance boundary changes. The Board approved the sole middle school boundary scenario presented, as well as High School Boundary Scenario #1.

The approval follows several months of data analysis, review and engagement with the School Boundary Advisory Committee (SBAC) and the broader community.

The secondary boundary planning process included input from the district boundary planner, SBAC, and district staff, along with opportunities for community members to provide feedback through a survey.

District leaders will begin working closely with affected campuses and families to support a smooth transition ahead of the 2027–28 school year. Additional information, including transition timelines and campus support plans, will be shared with families in the coming weeks.

More information about the boundary planning process and approved boundary changes can be found at www.fortbendisd.gov/attendanceboundaries.

###

Fort Bend ISD is the sixth-largest school district in Texas, serving over 75,000 students and employing more than 10,000 employees. The District is committed to providing a high-quality education in a safe and supportive environment.

Approved High School Boundaries


Current: Travis
Proposed: Bush
Projected Residents: 464

Current: Austin
Proposed: Travis
Projected Residents : 2

Total Projected Resident Students Impacted: 1,050

Current: Austin
Proposed: Clements
Projected Residents: 11

Current: Elkins
Proposed: Clements
Projected Residents: 473

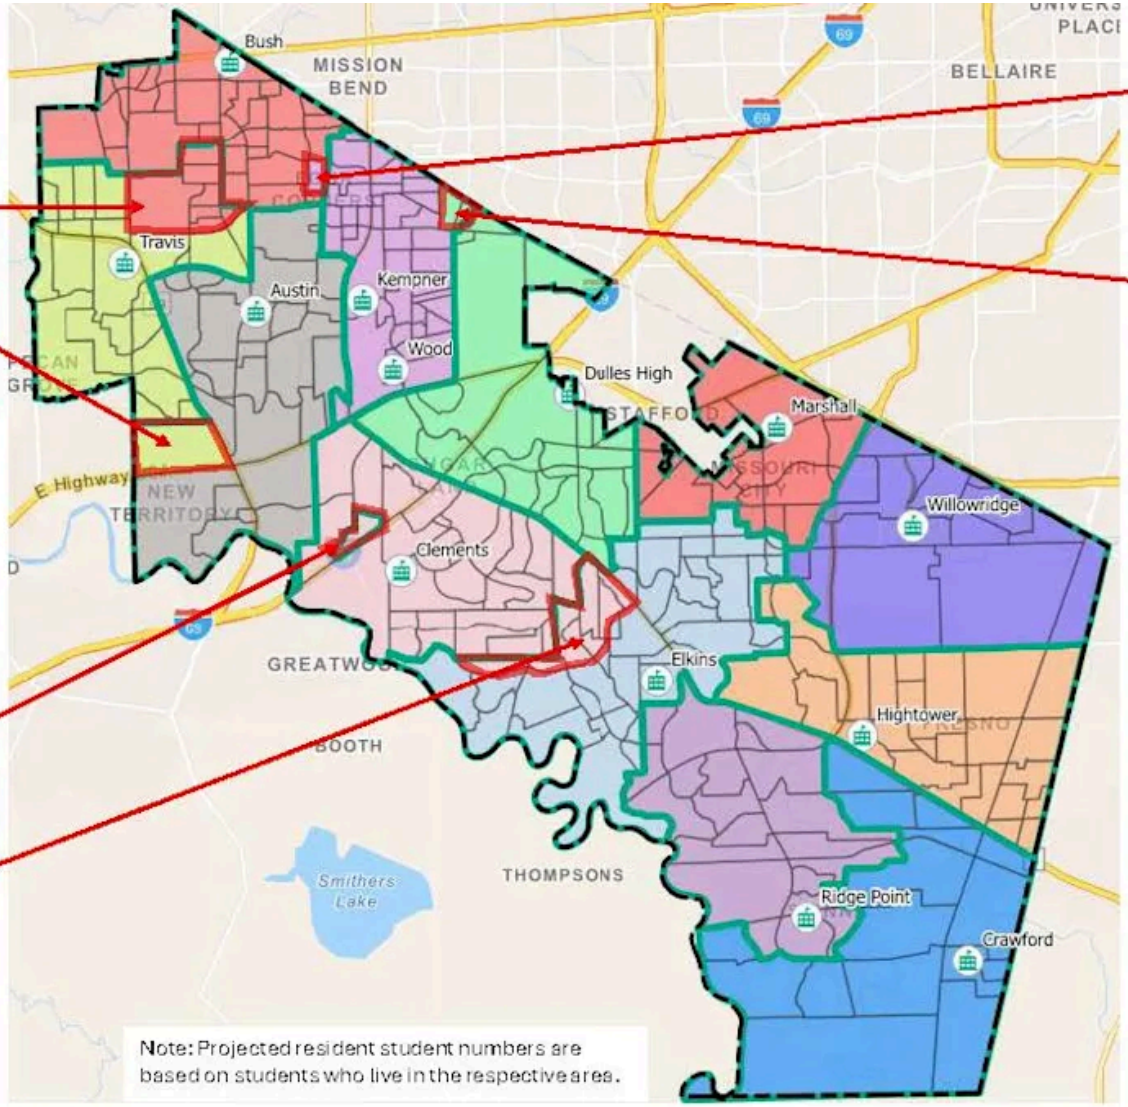

Current: Bush
Proposed: Kempner
Projected Residents: 78

Current: Kempner
Proposed: Dulles
Projected Residents: 27

School
Austin
Bush
Clements
Crawford
Dulles High
Elkins
Hightower
Kempner
Marshall
Ridge Point
Travis
Willowridge

Green lines = Current Boundaries
Color = New Boundaries
Red lines = Boundary Changes